


F.H.W.A. REG. NO.	B.I.A. REGION	RESER- VATION	PROJECT NO.	SHEET NO.	TOTAL SHEETS
	MIDWEST	RED LAKE		1	27

RED LAKE FORCEMAIN
WASTEWATER TREATMENT FACILITY
PLAN AND PROFILE
GRADING PLAN
RED LAKE RESERVATION
BELTRAMI COUNTY, MINNESOTA

I HEREBY CERTIFY THAT THIS PLAN, SPECIFICATION
OR REPORT WAS PREPARED BY ME OR UNDER MY
DIRECT SUPERVISION AND THAT I AM A DULY
LICENSED PROFESSIONAL ENGINEER UNDER THE
LAWS OF THE STATE OF MINNESOTA.

Michael C. McFarlane
MICHAEL C. MCFARLANE LIC. NO. 44196

AS-BUILT

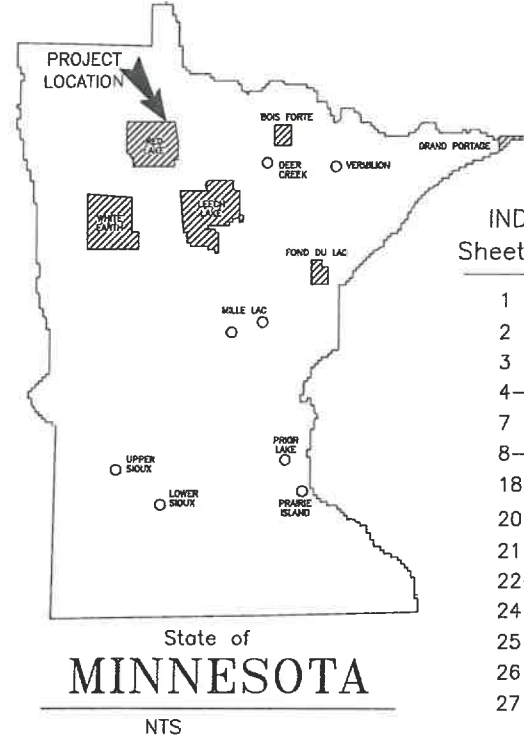


Sheet No.	Description
1	TITLE SHEET
2	ESTIMATE SHEET
3	OVERVIEW SHEET
4-6	DETAIL SHEETS
7	TRAFFIC CONTROL SHEET
8-17	FORCEMAIN PLAN PROFILE
18-19	EROSION CONTROL - SWPPP
20	FENCING LAYOUT
21	CLEARING AND GRUBBING PLAN
22-23	GRADING PLAN
24	CONTROL PIPING / STRUCTURE LAYOUT
25	SITE SURFACING LAYOUT
26	CONNECTION TO EXISTING FORCEMAIN
27	GEOMEMBRANE FABRICATION / INSTALLATION SPECS



LEGEND

- | DESCRIPTION |
|---|
| SIGN |
| LAKE |
| GAS MAIN |
| WATER LINE |
| FORCE MAIN |
| GRADE TO DRAIN |
| WATER FLOW |
| ROAD RIGHT-OF-WAY |
| PROPERTY LINES |
| CONSTRUCTION LIMITS |
| UNDERGROUND TELEPHONE CABLE WITH PED |
| UNDERGROUND ELECTRICAL WITH TRANSFORMER |
| OVERHEAD TELEPHONE CABLE |
| OVERHEAD ELECTRICAL CABLE |
| TREE LINE |
| UTILITY POLE/GUY POLE/ANCHOR |
| LIGHT POLE |
| WELL |
| SOIL BORING |
| BENCH MARK |
| CONTROL POINT |
| PROPOSED CULVERT WITH APRONS |
| PROPERTY CORNERS |
| FOUND MONUMENT |
| NO MONUMENT FOUND |

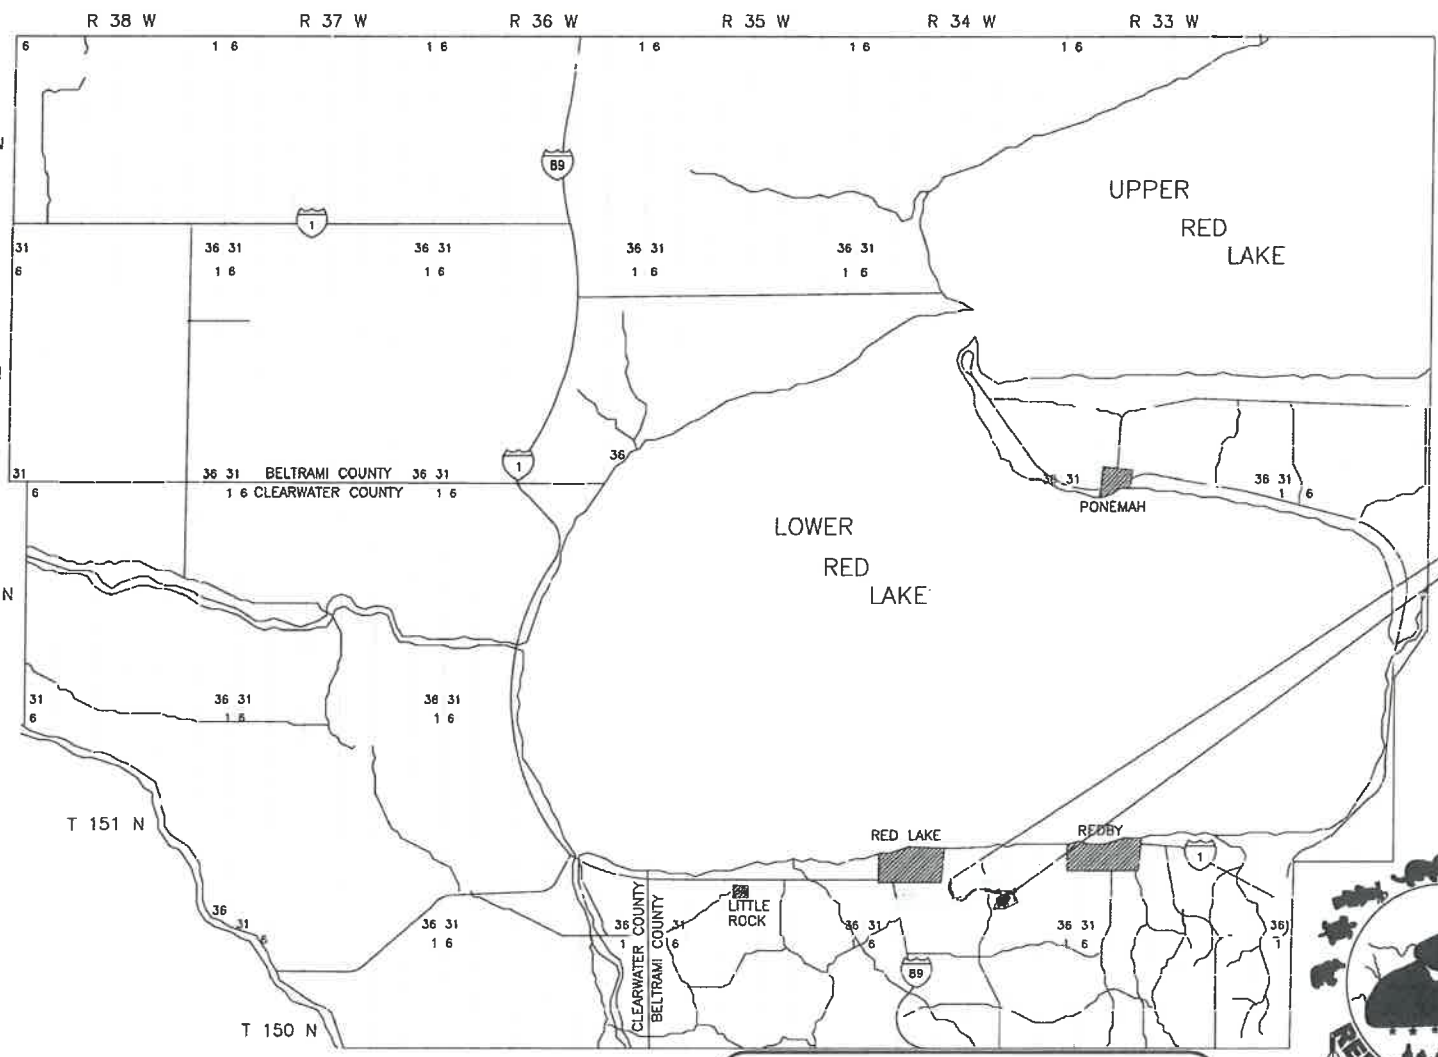

FORCEMAIN AND
WASTEWATER TREATMENT FACILITY

THE LOCATIONS OF EXISTING UNDERGROUND UTILITIES ARE SHOWN IN AN APPROXIMATE WAY ONLY AND HAVE NOT BEEN INDEPENDENTLY VERIFIED BY THE OWNER OR ITS REPRESENTATIVE. THE CONTRACTOR SHALL DETERMINE THE EXACT LOCATION OF ALL EXISTING UTILITIES BEFORE COMMENCING WORK, AND AGREES TO BE FULLY RESPONSIBLE FOR ANY AND ALL DAMAGES WHICH MIGHT BE OCCASIONED BY THE CONTRACTOR'S FAILURE TO EXACTLY LOCATE AND PRESERVE ANY AND ALL UNDERGROUND UTILITIES.

WARNING
LOCATION OF UNDERGROUND UTILITIES
TO BE VERIFIED BY CONTRACTOR
GOPHER STATE ONE CALL
CALL BEFORE DIGGING,
1-800-252-1166
REQUIRED BY LAW

Except as provided in the Special Provisions, all work shall be accomplished under the MINNESOTA DEPARTMENT OF TRANSPORTATION "STANDARD SPECIFICATIONS FOR CONSTRUCTION", 2005 Edition, and the latest "SUPPLEMENTAL SPECIFICATIONS" thereto.

Red Lake Band of Chippewa Indians
Tribal Engineering
P.O. Box 274, Red Lake, MN 56671



APPROVED	
TRIBAL CHAIRMAN	DATE

S:\MECH\Projects\03-42-21 waste water (Ransom)\03-42-21 Waste Water (Ransom)\03-42-21 EST.dwg, Model 3/29/2011 2:48:46 PM, sspool

STATEMENT OF ESTIMATED QUANTITIES			
ITEM NUMBER	ITEM	UNIT	ESTIMATED QUANTITIES
			EST
2021.501	MOBILIZATION	L.S.	1
2105.501	CLEARING	ACRE	27.33
2101.506	GRUBBING	ACRE	27.33
2105.523	COMMON EXCAVATION (P)	C.Y.	367530
2123.509	DOZER HOURS	HOUR	81
2211.501	AGGREGATE BASE CLASS 5 (MODIFIED)	TON	5360
2511.501	RIPRAP	C.Y.	40
2557.501	WIRE FENCE, DESIGN CHAIN LINK	L.F.	7320
2573.502	SILT FENCE, MACHINE SLICED AND MAINTAINED	L.F.	7825
2575.501	SEEDING	ACRE	39.63
2575.502	SEED, MIXTURE 240	LBS.	3963
2575.511	MULCH MATERIAL, TYPE 4	TON	74.31
2575.523	EROSION CONTROL BLANKET (C.O. #1)	S.Y.	25953
2722	REHAB EXISTING SECONDARY POND	L.S.	1
2722	CONNECT TO EXISTING FORCEMAIN	L.S.	1
2722	8" PVC FORCEMAIN	L.F.	13150
2722	PRIMARY INFLUENT STRUCTURE	L.S.	1
2722	PRIMARY EFFLUENT CONTROL STRUCTURE	L.S.	1
2722	SECONDARY EFFLUENT CONTROL STRUCTURE A	L.S.	1
2722	SECONDARY EFFLUENT CONTROL STRUCTURE B	L.S.	1
2722	PRIMARY CROSSOVER CONTROL STRUCTURE	L.S.	1
2722	SECONDARY CROSSOVER CONTROL STRUCTURE	L.S.	1
2722	WATER BALANCE (PRE-FILL)	L.S.	1
2722	INTERPOND PIPING (8" DIP)	L.F.	2774
2722	INTERPOND PIPING (8" PVC)	L.F.	323
2722	REINFORCED POLYPROPYLENE LINER	S.F.	1692872
2722	NEW LIFT STATION	L.S.	1
2722	AIR RELEASE MANHOLES	EACH	6
2722	SAFETY LADDER	L.F.	384
2722	LEVEL INDICATOR	EACH	4

- ① INCLUDES ALL MATERIALS AND WORK INCLUDING GATES AS CALLED FOR IN THE PLANS. ALSO INCLUDES METAL SIGNS STATING "DANGER WASTEWATER TREATMENT FACILITIES" TO BE INSTALLED ON FENCE AT 20 LOCATIONS AS DETERMINED BY THE ENGINEER.
- ② REFER TO SHEET 26 FOR DETAILS.
- ③ INCLUDED ALL SLEEVES, WYE, VALVES, AND OTHER APPURTENANCES NECESSARY FOR MAKING CONNECTION AS SHOWN IN DETAIL ON SHEET 26.
- ④ INCLUDES ALL MATERIALS AND WORK INVOLVED WITH POND PIPING INCLUDING PIPE, FITTINGS, SPLASH PADS, PIPING DRAINS, AND OTHER APPURTENANCES WITHIN CONTROL STRUCTURES.
- ⑤ INCLUDES ALL MATERIALS AND WORK INVOLVED WITH LINER PENETRATIONS INCLUDING APPROVED LINER BOOTS OR OTHER TYPES OF SEALS APPROVED BY THE ENGINEER. NO PAYMENT WILL BE MADE FOR OVERLAP AREA FOR SEAMS.
- ⑥ APPROVED SAFETY LADDERS SHALL BE PERMANENTLY INSTALLED AT 4 LOCATIONS IN EACH PRIMARY CELL AND 2 LOCATIONS IN EACH SECONDARY CELL EXTENDING FROM POND BOTTOM TO TWO FEET BELOW TOP OF BERMS.
- ⑦ APPROVED POND LEVEL INDICATORS SHALL BE INSTALLED IN EACH PRIMARY AND SECONDARY CELL. INDICATORS SHALL BE HIGHLY VISIBLE FROM CONTROL STRUCTURES.

MANHOLE & CONTROL STRUCTURE SCHEDULE											
DESIGNATION	DESIGN	RIM ELEV	BOTTOM ELEV	RIM TO INVERT HEIGHT	FRAME CASTING	COVER CASTING	LOCATION	STATION & OFFSET	SEWER TYPE	SHEET NO.	REMARKS
ARMH-1	4007C	1252.00	1241.30	10.70	700-7	716	FORCEMAIN EASEMENT	5+89	8" PVC FORCEMAIN	8	FURNISH AND INSTALL NEW STRUCTURE
ARMH-2	4007C	1254.60	1243.90	10.70	700-7	716	FORCEMAIN EASEMENT	16+40	8" PVC FORCEMAIN	9	FURNISH AND INSTALL NEW STRUCTURE
VMH-1	4007C	1233.50	1222.80	10.70	700-7	716	FORCEMAIN EASEMENT	23+96, 9' RT	8" PVC FORCEMAIN	9	FURNISH AND INSTALL NEW STRUCTURE
ARMH-3	4007C	1283.30	1272.60	10.70	700-7	716	WA-ZA-WA-NI-KWAY-KUNA-ROAD-B	34+69	8" PVC FORCEMAIN	10	FURNISH AND INSTALL NEW STRUCTURE
ARMH-4	4007C	1266.00	1255.30	10.70	700-7	716	THUNDER LAKE ROAD	50+73	8" PVC FORCEMAIN	11	FURNISH AND INSTALL NEW STRUCTURE
ARMH-5	4007C	1259.30	1248.60	10.70	700-7	716	PROPOSED THUNDER LAKE ROAD	89+72	8" PVC FORCEMAIN	14	FURNISH AND INSTALL NEW STRUCTURE
ARMH-6	4007C	1266.00	1255.30	10.70	700-7	716	PROPOSED THUNDER LAKE ROAD	112+40	8" PVC FORCEMAIN	16	FURNISH AND INSTALL NEW STRUCTURE
CS-1	*	1292.65	1286.15	6.50	*	*	WASTEWATER TREATMENT SITE		8" FORCEMAIN/GRAVITY SEWER	24	PRIMARY INFLUENT STRUCTURE
CS-2	*	1292.65	1279.50	13.15	*	*	WASTEWATER TREATMENT SITE		8" GRAVITY SEWER	24	PRIMARY EFFLUENT CONTROL STRUCTURE
CS-3	*	1292.65	1280.00	12.65	*	*	WASTEWATER TREATMENT SITE		8" GRAVITY SEWER	24	PRIMARY CROSSOVER CONTROL STRUCTURE
CS-4	*	1287.15	1275.00	12.15	*	*	WASTEWATER TREATMENT SITE		8" GRAVITY SEWER	24	SECONDARY CROSSOVER CONTROL STRUCTURE
CS-5	*	1287.15	1274.50	12.65	*	*	WASTEWATER TREATMENT SITE		8" GRAVITY SEWER	24	SECONDARY EFFLUENT CONTROL STRUCTURE A
CS-6	*	1287.15	1273.50	13.65	*	*	WASTEWATER TREATMENT SITE		8" GRAVITY SEWER	24	SECONDARY EFFLUENT CONTROL STRUCTURE B

* SEE DETAIL

STANDARD PLATES	
PLATE NO.	DESCRIPTION
0005 A	SPECIFICATION REFERENCE TO STANDARD PLATES (1988) (2 SHEETS)
3000 L	REINFORCED CONCRETE PIPE (5 SHEETS)
4006 L	MANHOLE OR CATCH BASIN (DESIGN G OR DESIGN H)
4007 C	PRECAST MECHANICAL JOINT SEWER MANHOLE
4010 G	CONCRETE SHORT CONE & ADJUSTING RING
4011 D	PRECAST CONCRETE BASE
4101 C	RING CASTING FOR MANHOLE OR CATCH BASIN
4108 F	ADJUSTING RINGS FOR CATCH BASINS AND MANHOLES
4110 E	COVER CASTING FOR MANHOLE
4149 C	GRATE CASTING FOR CATCH BASIN
4161 F	CURB BOX CASTING FOR CATCH BASIN
4180 H	MANHOLE OR CATCH BASIN STEP
7035 J	CONCRETE WALK & CURB RETURNS AT ENTRANCES
7036 D	PEDESTRIAN CURB RAMP (FOR THE HANDICAPPED)
7100 G	CONCRETE CURB AND GUTTER (DESIGN B AND DESIGN V)
7111 H	INSTALLATION & REINFORCEMENT OF CATCH BASIN CASTINGS (CONCRETE CURB & CURB AND GUTTER)
8000 I	STANDARD BARRICADES (2 SHEETS)
9102 D	TURF ESTABLISHMENT AREAS (AT PIPE CULVERT ENDS)

BASIS OF ESTIMATED QUANTITIES	
AGGREGATE BASE, CLASS 5.....	140 POUNDS PER CUBIC FOOT
SEED, MIXTURE 240.....	100 POUNDS PER ACRE
COMMERCIAL FERTILIZER, ANALYSIS 12-12-12.....	500 POUNDS PER ACRE
MULCH, TYPE 4.....	3750 POUNDS PER ACRE

CONSTRUCTION NOTES	
(1)	THE LOCATION OF EXISTING UTILITIES ARE SHOWN FOR INFORMATION ONLY, AND REPRESENT THE BEST KNOWLEDGE OF THE ENGINEER. IT SHALL BE THE CONTRACTORS RESPONSIBILITY TO VERIFY THE LOCATION OF THESE UTILITIES PRIOR TO COMMENCING CONSTRUCTION.
(2)	CONTRACTOR TO USE FACTORY FABRICATED PIPE SEALS OR ANTI-SEEPAGE COLLARS AT ALL PIPE PENETRATIONS AS APPROVED BY ENGINEER.
(3)	ALL POLES TO BE REMOVED AND OR RELOCATED SHALL BE BY OTHERS PRIOR TO COMMENCING CONSTRUCTION.
(4)	EXCESS EXCAVATION SHALL BE DISPOSED OF BY THE CONTRACTOR, AS DIRECTED BY THE ENGINEER OR OWNER, WITHIN A DISTANCE OF 1.5 MILES. THIS WORK SHALL BE CONSIDERED INCIDENTAL TO THE CONTRACT AND NO ADDITIONAL COMPENSATION SHALL BE ALLOWED.
(5)	ALL DISTURBED AREAS, NOT OTHERWISE SURFACED, SHALL BE SEEDED AND MULCHED.
(6)	ALL BACKFILL CONSTRUCTION FOR WATERMAINS, SANITARY SEWERS AND STORM SEWERS SHALL BE IN ACCORDANCE WITH MN/DOT SPEC 2451 AND COMPACTION SHALL BE IN ACCORDANCE WITH 2105.3F1, SPECIFIED DENSITY.
(7)	THE CONTRACTOR SHALL TAKE ALL NECESSARY PRECAUTIONS TO PREVENT SILT, SOIL AND OTHER SUSPENDED PARTICLES FROM BEING DISCHARGED TO THE BODIES OF WATER OR DRAINAGE STRUCTURES IN THE CONSTRUCTION VICINITY. THE COST OF THIS WORK SHALL BE CONSIDERED INCIDENTAL, UNLESS PAID FOR SPECIFICALLY IN THE PLANS.
(8)	BITUMINOUS MATERIAL FOR MIXTURE SHALL BE PG 58-28.
(9)	THE CONTRACTOR SHALL REMOVE MAIL BOXES AS NECESSARY AND REPLACE THEM WHEN THE WORK IS COMPLETE. THE COST OF THIS WORK SHALL BE CONSIDERED INCIDENTAL TO THE CONTRACT AND NO ADDITIONAL COMPENSATION SHALL BE ALLOWED.
(10)	EXISTING SOILS SHALL BE SCARIFIED TO A DEPTH OF SIX INCHES AND COMPACTED TO 98% OF MAXIMUM DENSITY PRIOR TO PLACING EMBANKMENT OR BASE COURSE IN ROADWAYS.

REVISIONS	
NO.	DATE
DESCRIPTION	
BY	

I HEREBY CERTIFY THAT THIS PLAN, SPECIFICATION, OR REPORT WAS PREPARED BY ME OR UNDER MY DIRECT SUPERVISION AND THAT I AM A DULY LICENSED PROFESSIONAL ENGINEER UNDER THE LAWS OF THE STATE OF MINNESOTA

Michael C. McFarlane
MICHAEL C. MCFARLANE, P.E. LIC. NO. 44198




RED LAKE WASTEWATER FACILITIES

ESTIMATE SHEET


RED LAKE RESERVATION, MN

JOB NO. 03-42-
DATE: 03-29-2011

SHEET NO.
2 OF 27

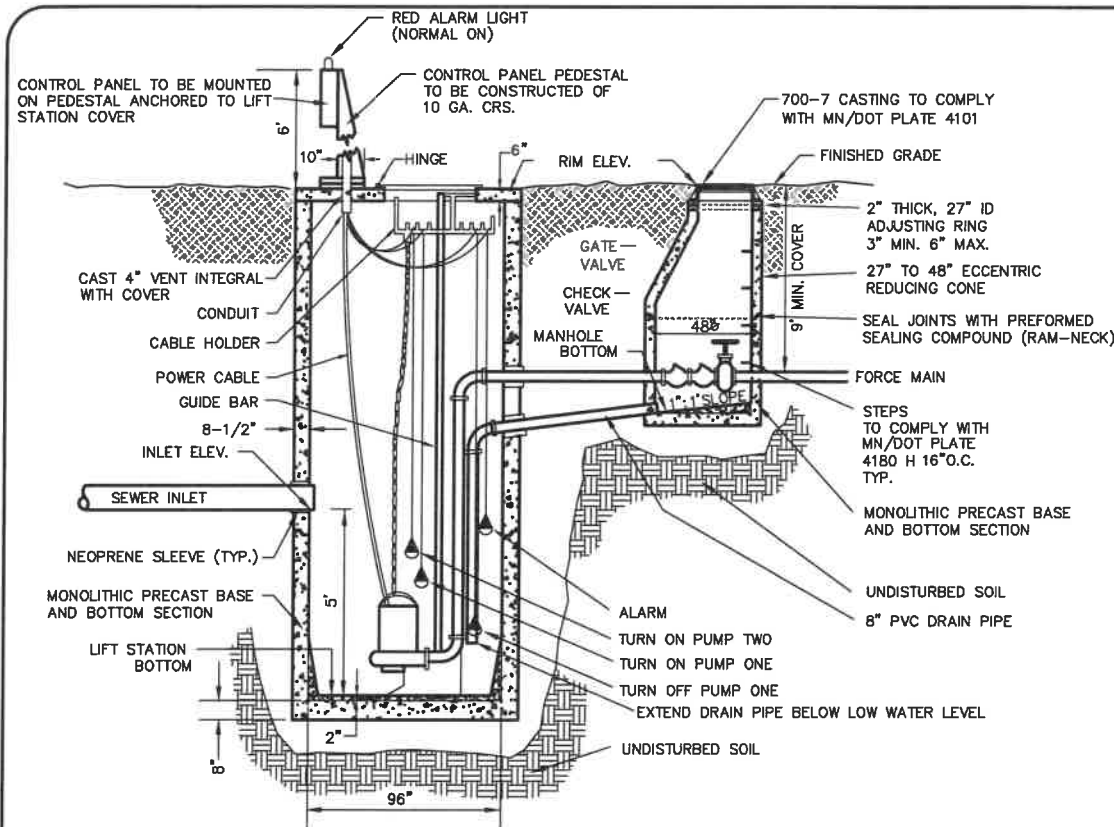


SECTION VIEW

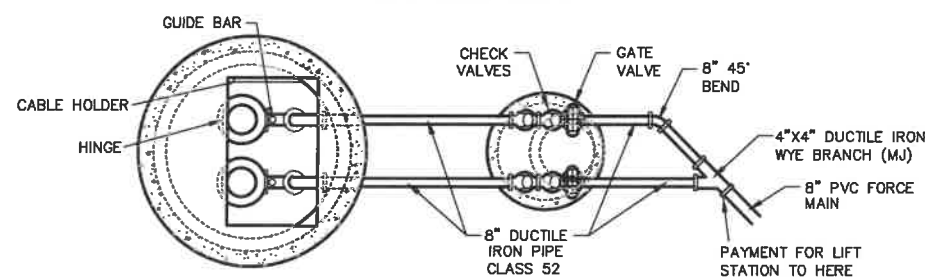


PLAN VIEW


1 SEWAGE LIFT STATION
NO SCALE

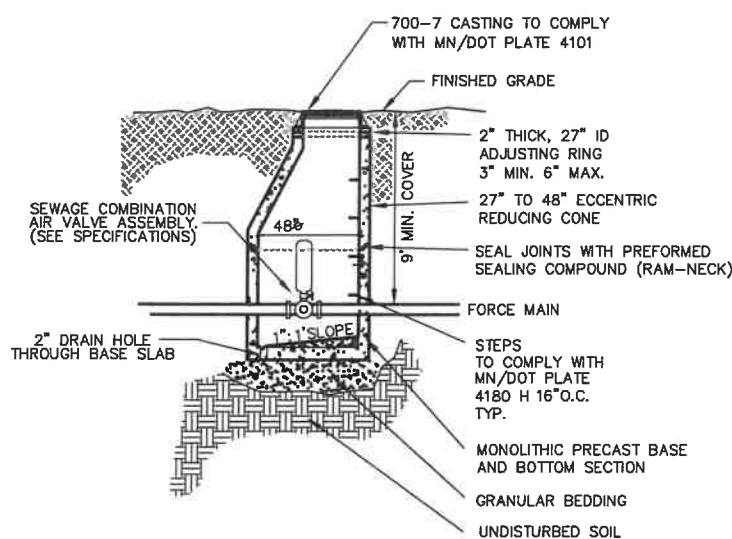


2 AIR RELEASE MANHOLE
NO SCALE

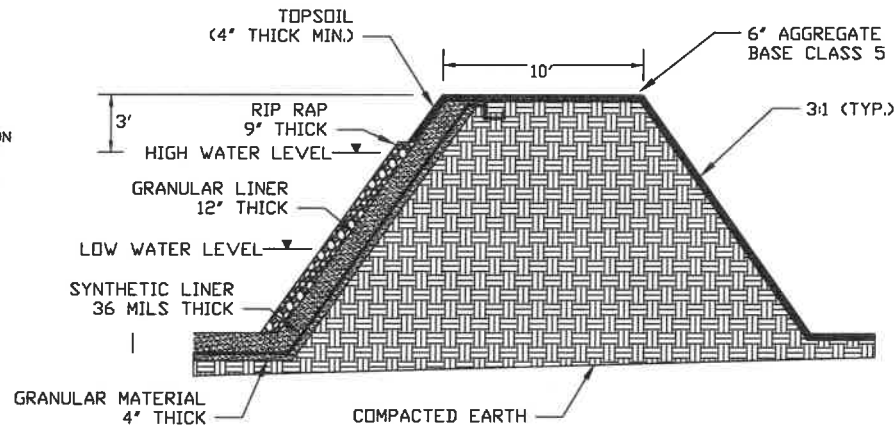


3 TYPICAL BERM CROSS SECTION
NO SCALE

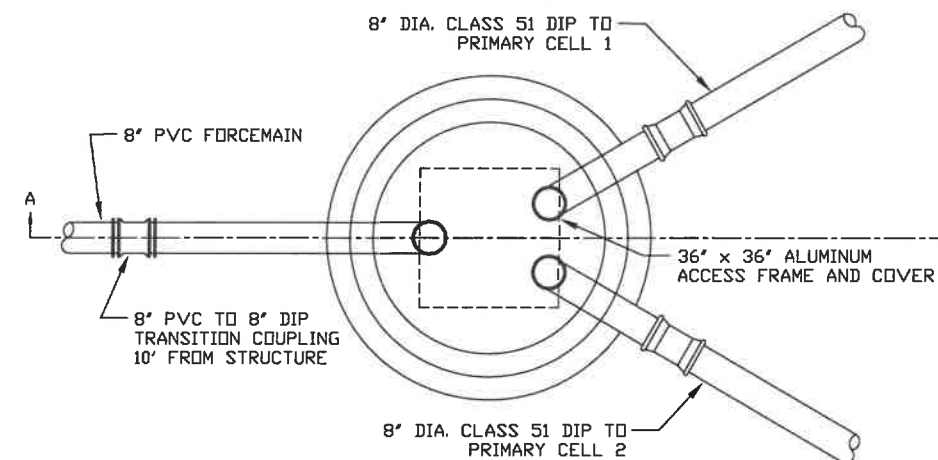


4 PRIMARY INFLUENT STRUCTURE
MECHANICAL PLAN
NO SCALE

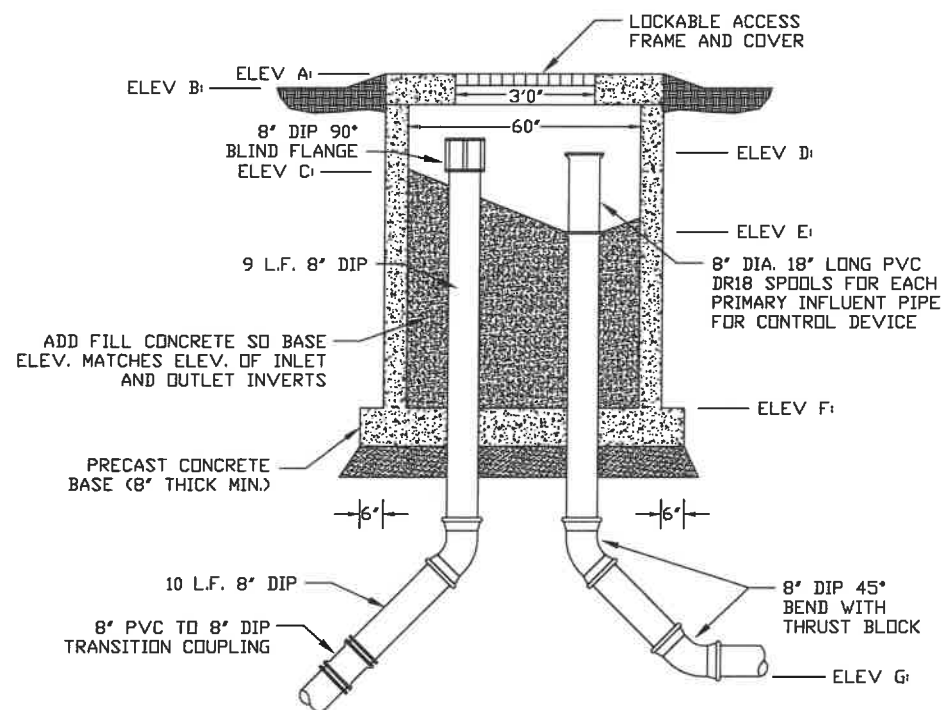


5 PRIMARY INFLUENT STRUCTURE
SECTION A-A
NO SCALE

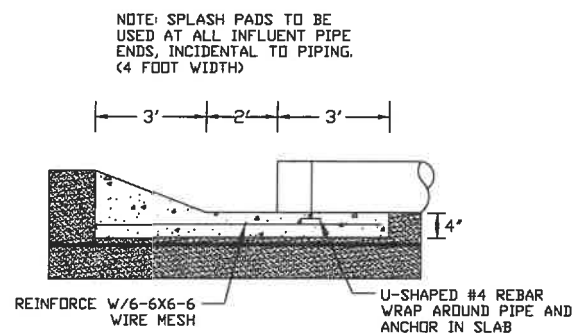

6 SPLASH PAD DETAIL
NO SCALE

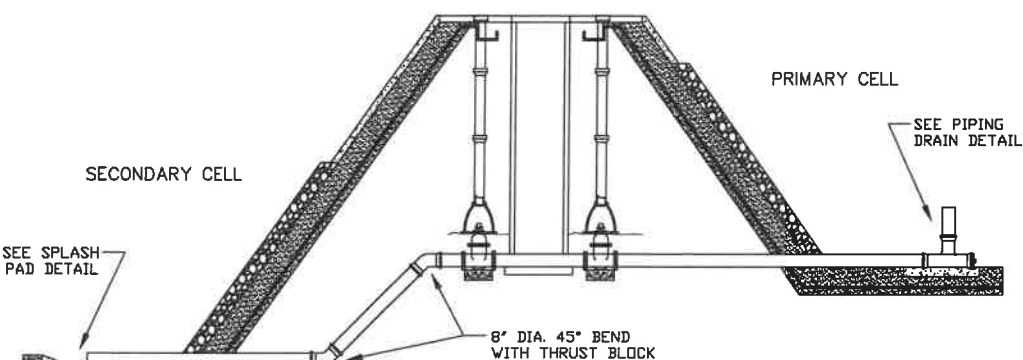

7 PRIMARY TO SECONDARY CELL CONNECTION
NO SCALE

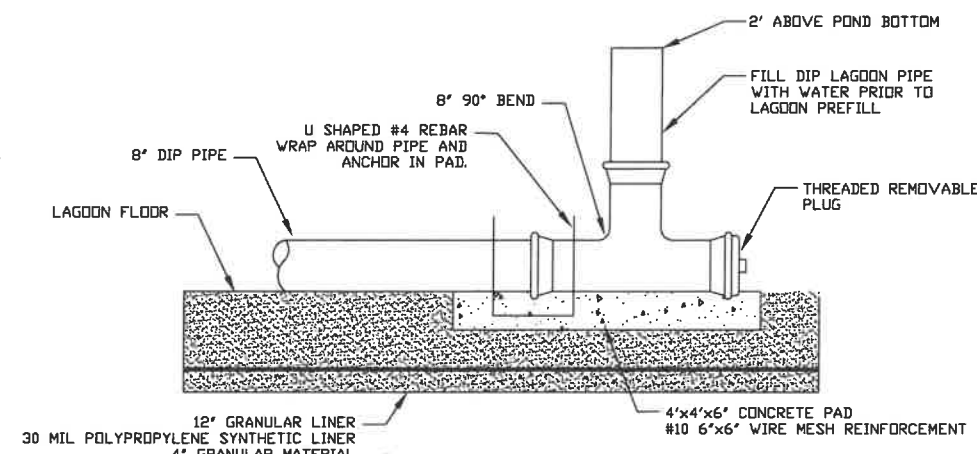

8 PIPING DRAIN DETAIL
NO SCALE

REVISIONS	DATE	DESCRIPTION	BY
AS-BUILT			

I HEREBY CERTIFY THAT THIS PLAN, SPECIFICATION OR REPORT WAS PREPARED BY ME OR UNDER MY CLOSE PERSONAL SUPERVISION AND THAT I AM A LICENSED PROFESSIONAL ENGINEER UNDER THE LAWS OF THE STATE OF MINNESOTA.







Michael C. McFarlane
MICHAEL C. MCFARLANE
REG. NO. 44198



RED LAKE WASTEWATER FACILITIES
DETAILS 1
RED LAKE RESERVATION, MINNESOTA

JOB NO. 03-42
DATE: 03-29-2011

SHEET NO.
04 OF 27

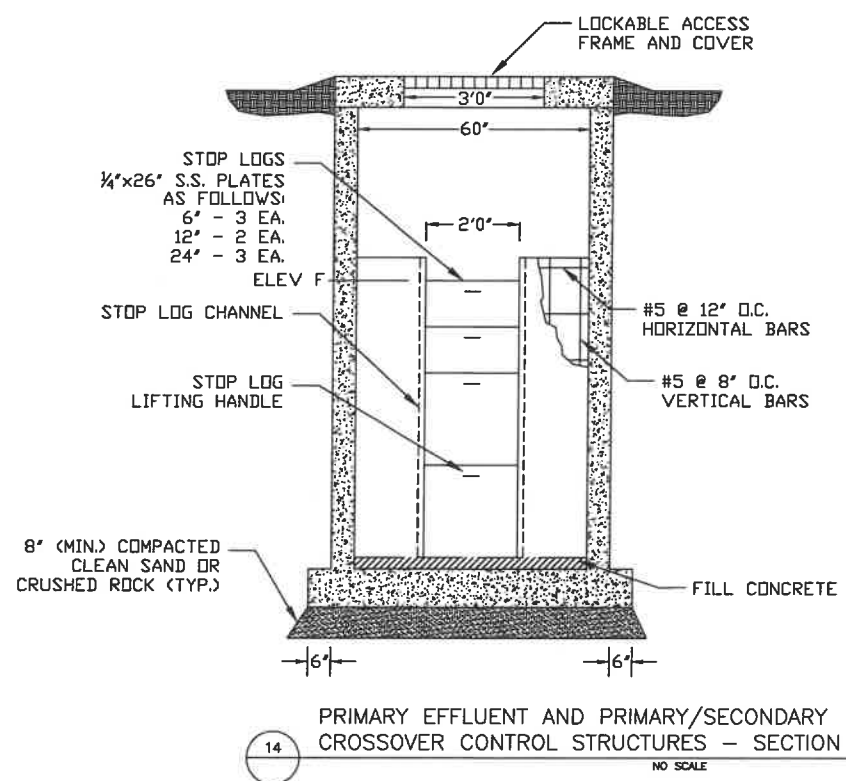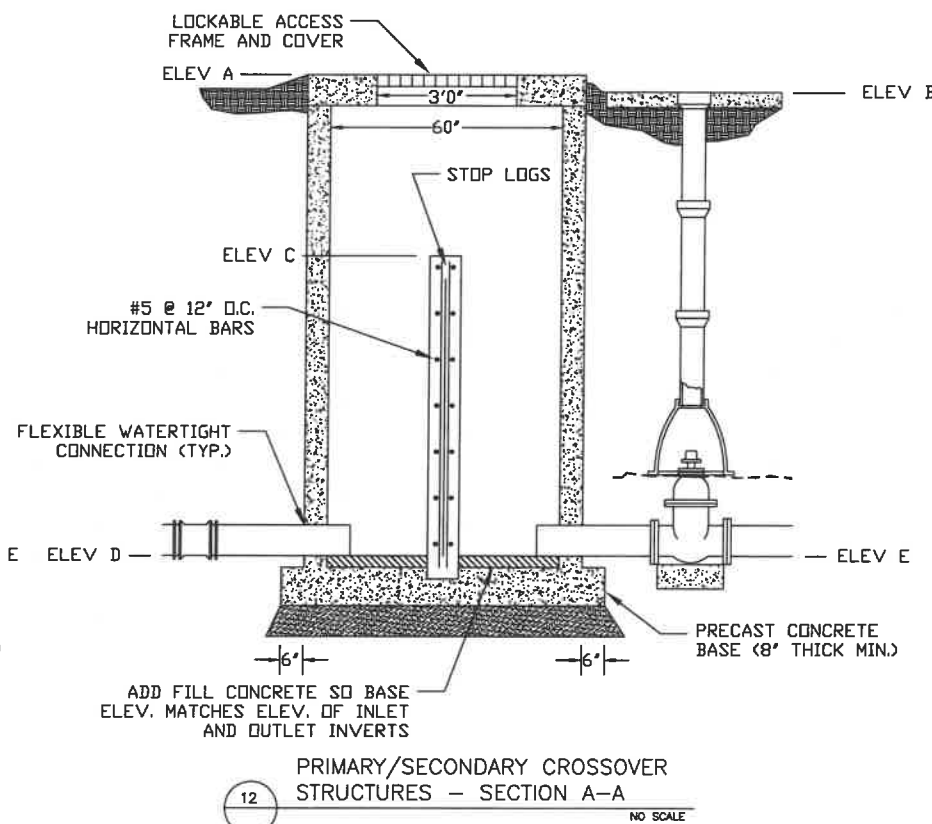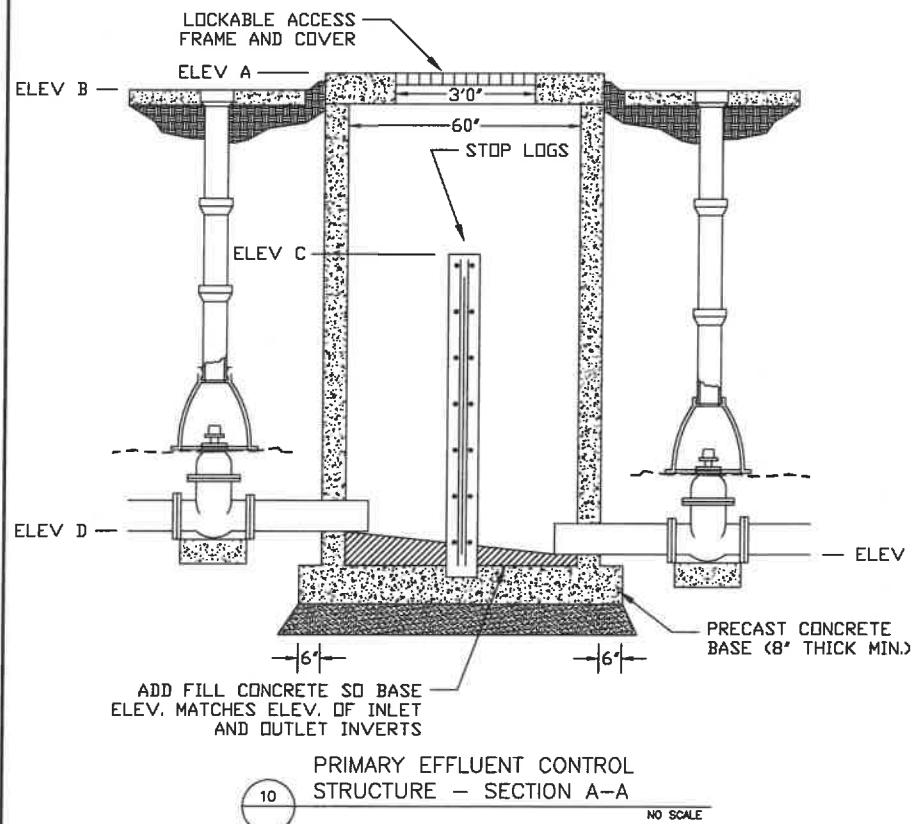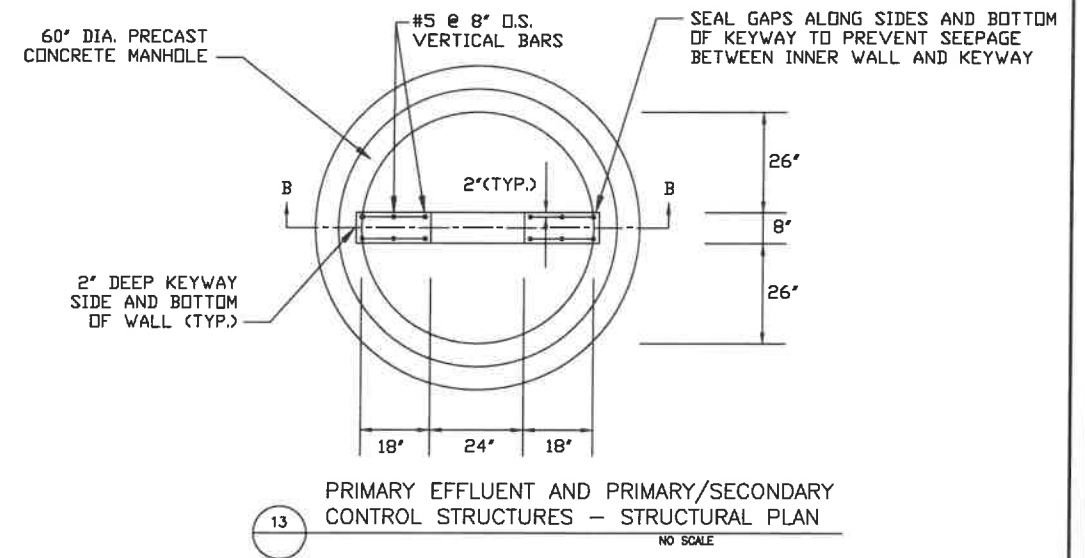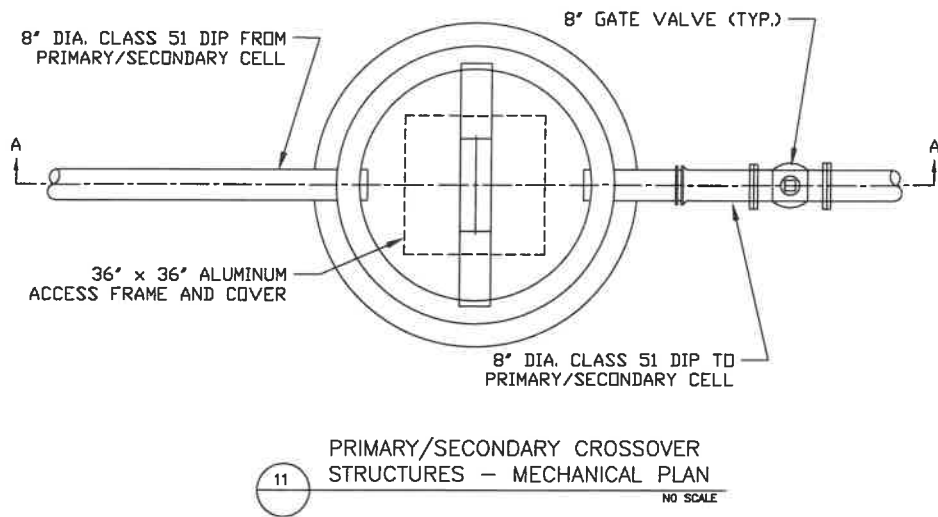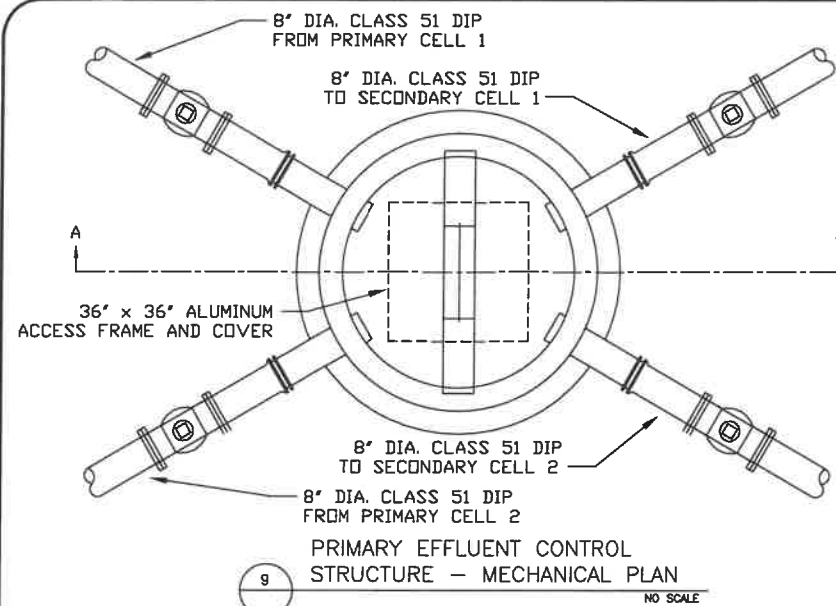

CONTROL STRUCTURE ELEVATION DATA:

PRIMARY INFLUENT: (60" DIA.)

A= 1292.65
B= 1292.40
C= 1291.15
D= 1291.65
E= 1290.15
F= 1286.15
G= 1279.00

PRIMARY EFFLUENT: (60" DIA.)

A= 1292.65
B= 1292.40
C= 1290.15
D= 1280.00
E= 1279.50
F= 1289.50

PRIMARY CROSSOVER: (60" DIA.)

A= 1292.65
B= 1292.40
C= 1290.65
D= 1280.00
E= 1280.00
F= 1289.50

CONTROL STRUCTURE ELEVATION DATA:

SECONDARY CROSSOVER: (60" DIA.)



A= 1287.15
B= 1286.90
C= 1284.50
D= 1275.00
E= 1275.00
F= 1284.00

SECONDARY EFFLUENT A: (72" DIA.)








A= 1287.15
B= 1286.90
C= 1284.50
D= 1275.00
E= 1274.50
F= 1284.00

SECONDARY EFFLUENT B: (60" DIA.)

A= 1287.15
B= 1286.90
C= 1284.50
D= 1274.00
E= 1273.50
F= 1284.00

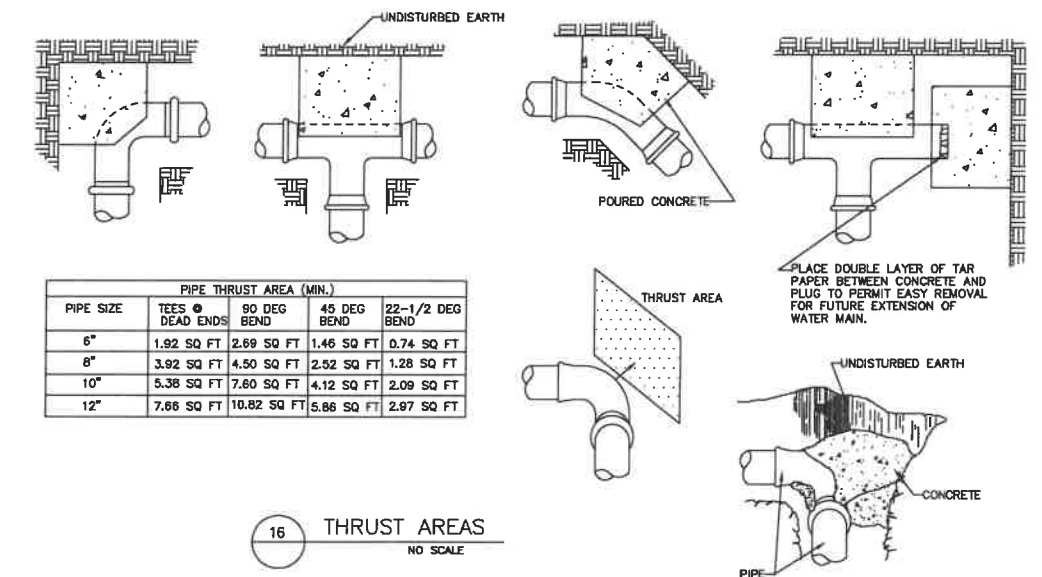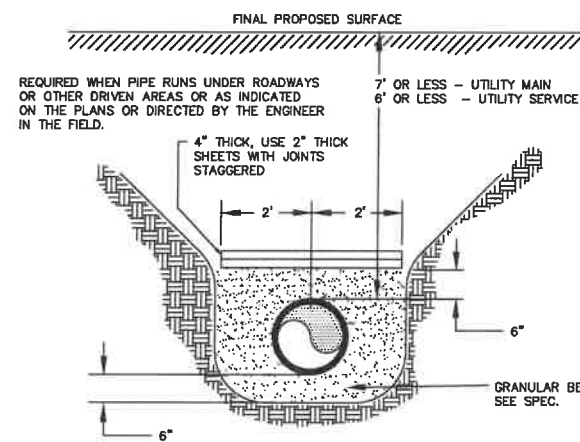

S:\NEC\Projects\03-42-rl waste water (legoon)\03-42 AS-BUILTS\dwg\03-42main.dwg, Sheet 6-Details 3, 3/29/2011 10:28:45 AM, snrnpf

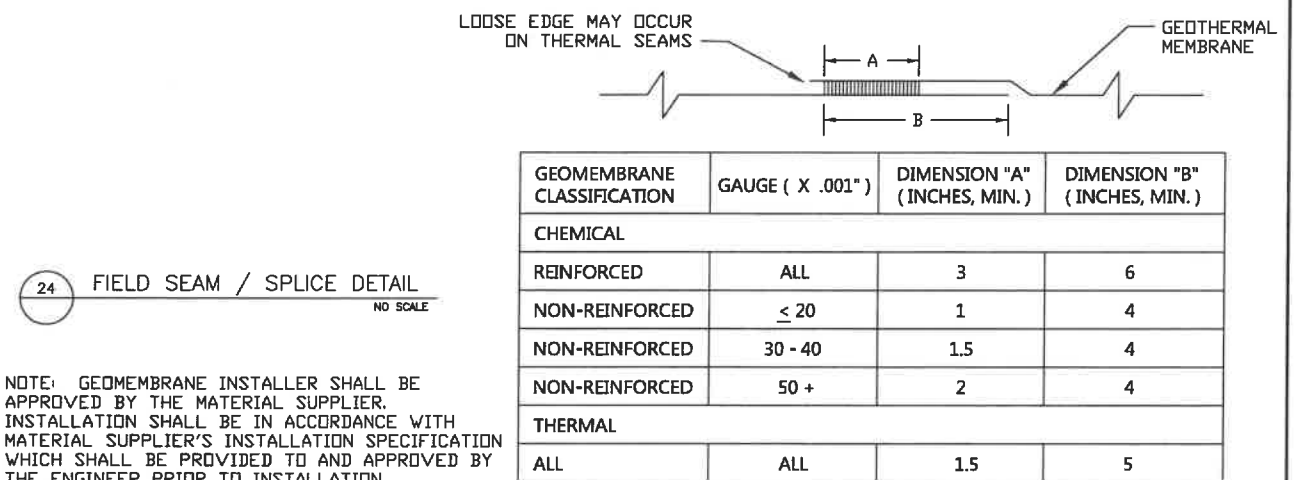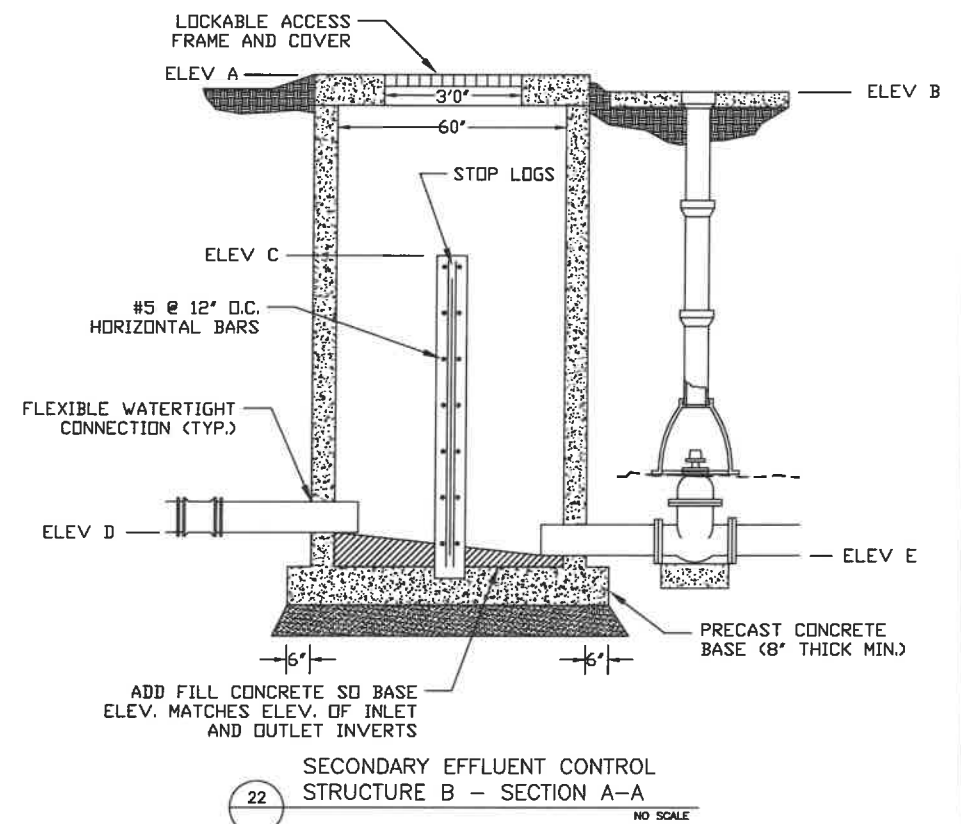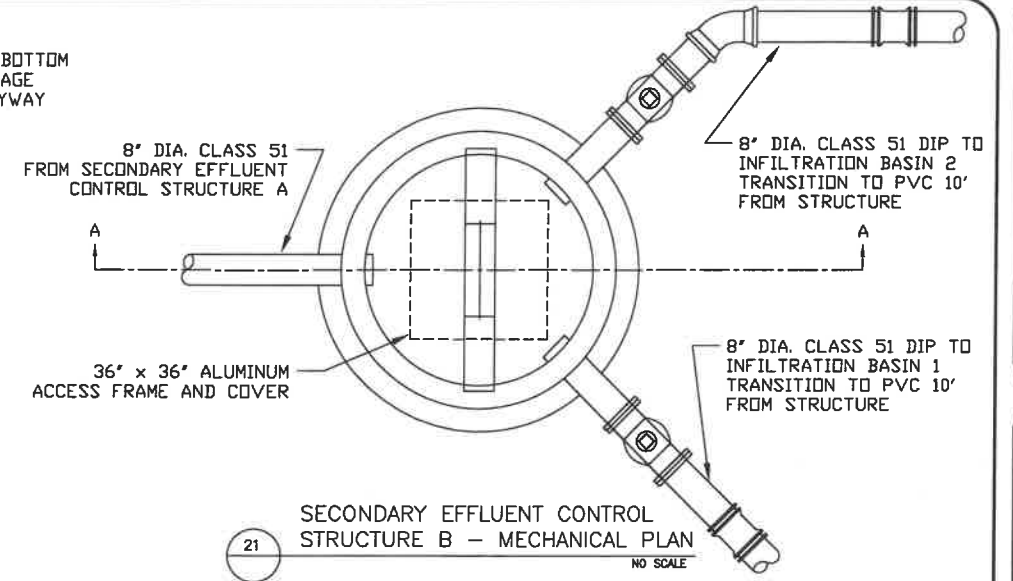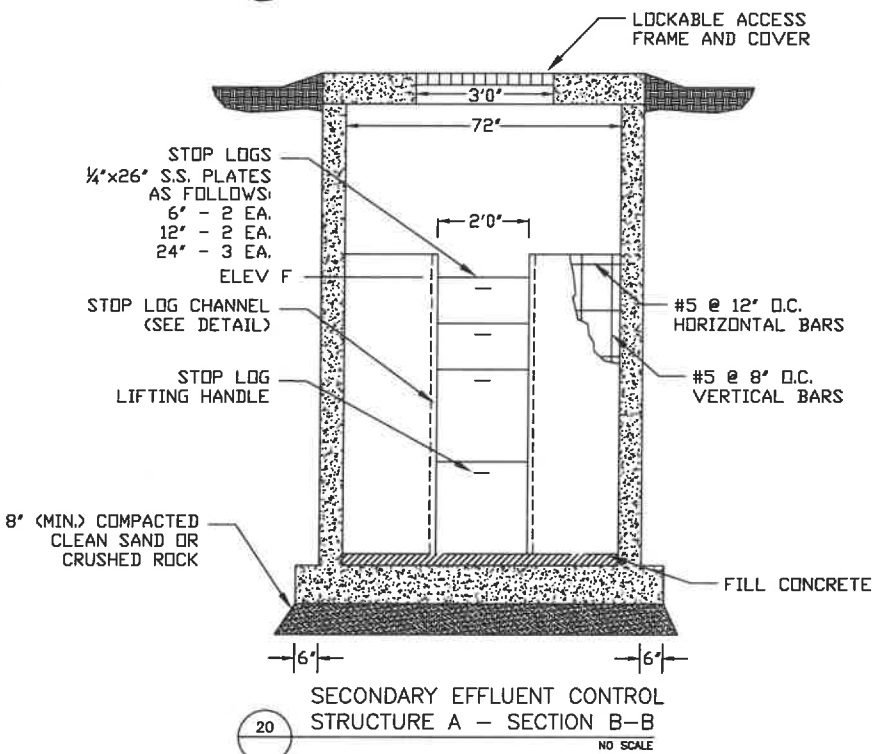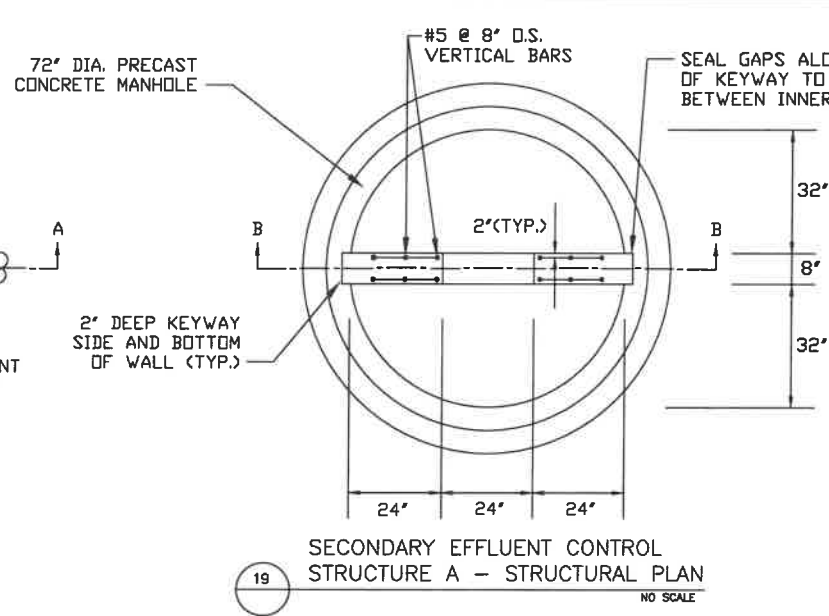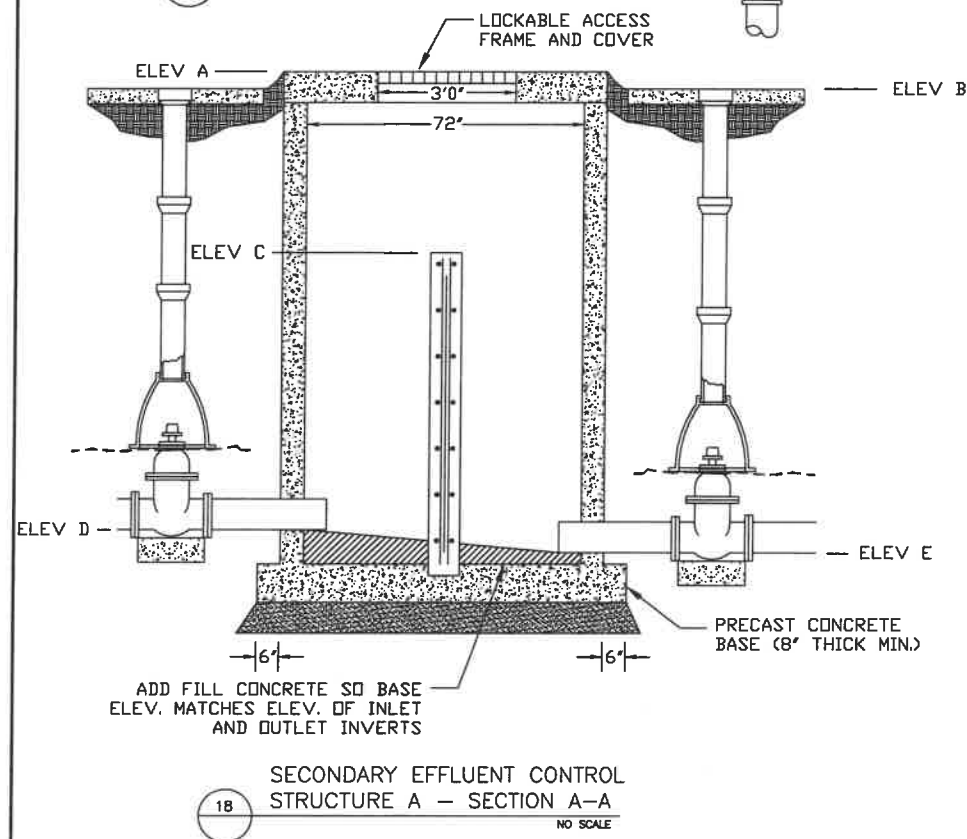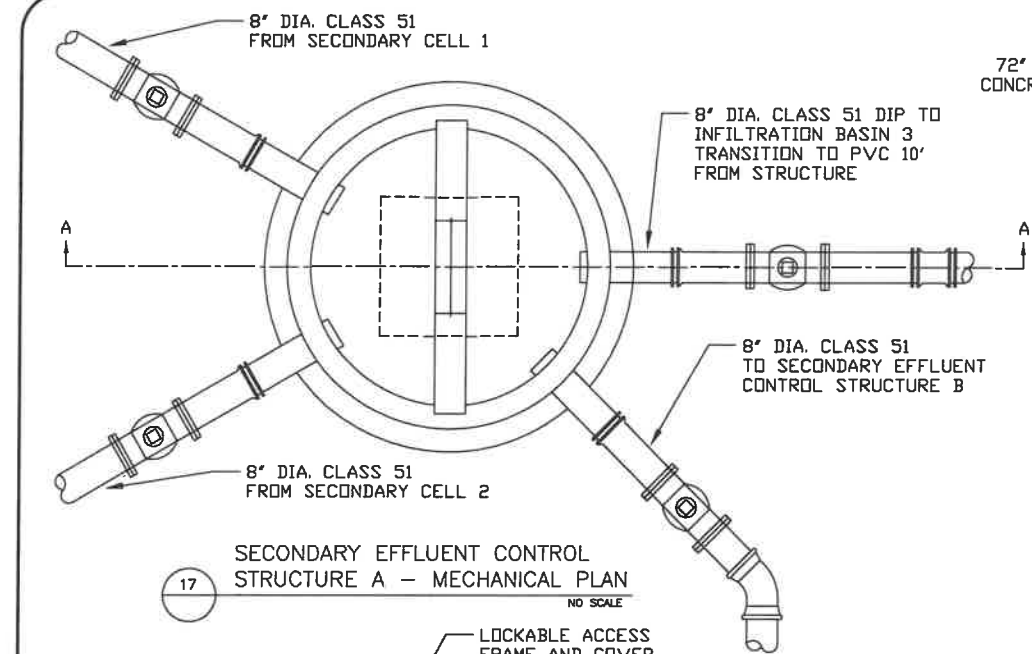

NOTE: GEOMEMBRANE INSTALLER SHALL BE APPROVED BY THE MATERIAL SUPPLIER. INSTALLATION SHALL BE IN ACCORDANCE WITH MATERIAL SUPPLIER'S INSTALLATION SPECIFICATION WHICH SHALL BE PROVIDED TO AND APPROVED BY THE ENGINEER PRIOR TO INSTALLATION.

REVISIONS
AS-BUILT
NO. DATE DESCRIPTION BY

I HEREBY CERTIFY THAT THIS PLAN, SPECIFICATION OR REPORT WAS PREPARED BY ME OR UNDER MY DIRECT SUPERVISION AND THAT I AM A DULY LICENSED PROFESSIONAL ENGINEER UNDER THE LAWS OF THE STATE OF MINNESOTA.
Michael C. McFarlane
MICHAEL C. MCFARLANE
REG. NO. 44196


RED LAKES ENGINEERING
S. CONSULTING, INC.
207 4th Street NW, Bemidji, MN 56601
Phone: 218-444-4860, Fax 218-444-6042
web: www.redusa.com

RED LAKE WASTEWATER FACILITIES
DETAILS 3
RED LAKE RESERVATION, MINNESOTA

JOB NO. 03-42
DATE: 03-29-2011

SHEET NO.
06 OF 27

S:\NEC\Projects\03-42 r1 waste water (legoon)\03-42 AS-BUILTS\dwg\03-42main.dwg, Sheet 7-Traffic Control 3/29/2011 10:30:29 AM, ssnapl

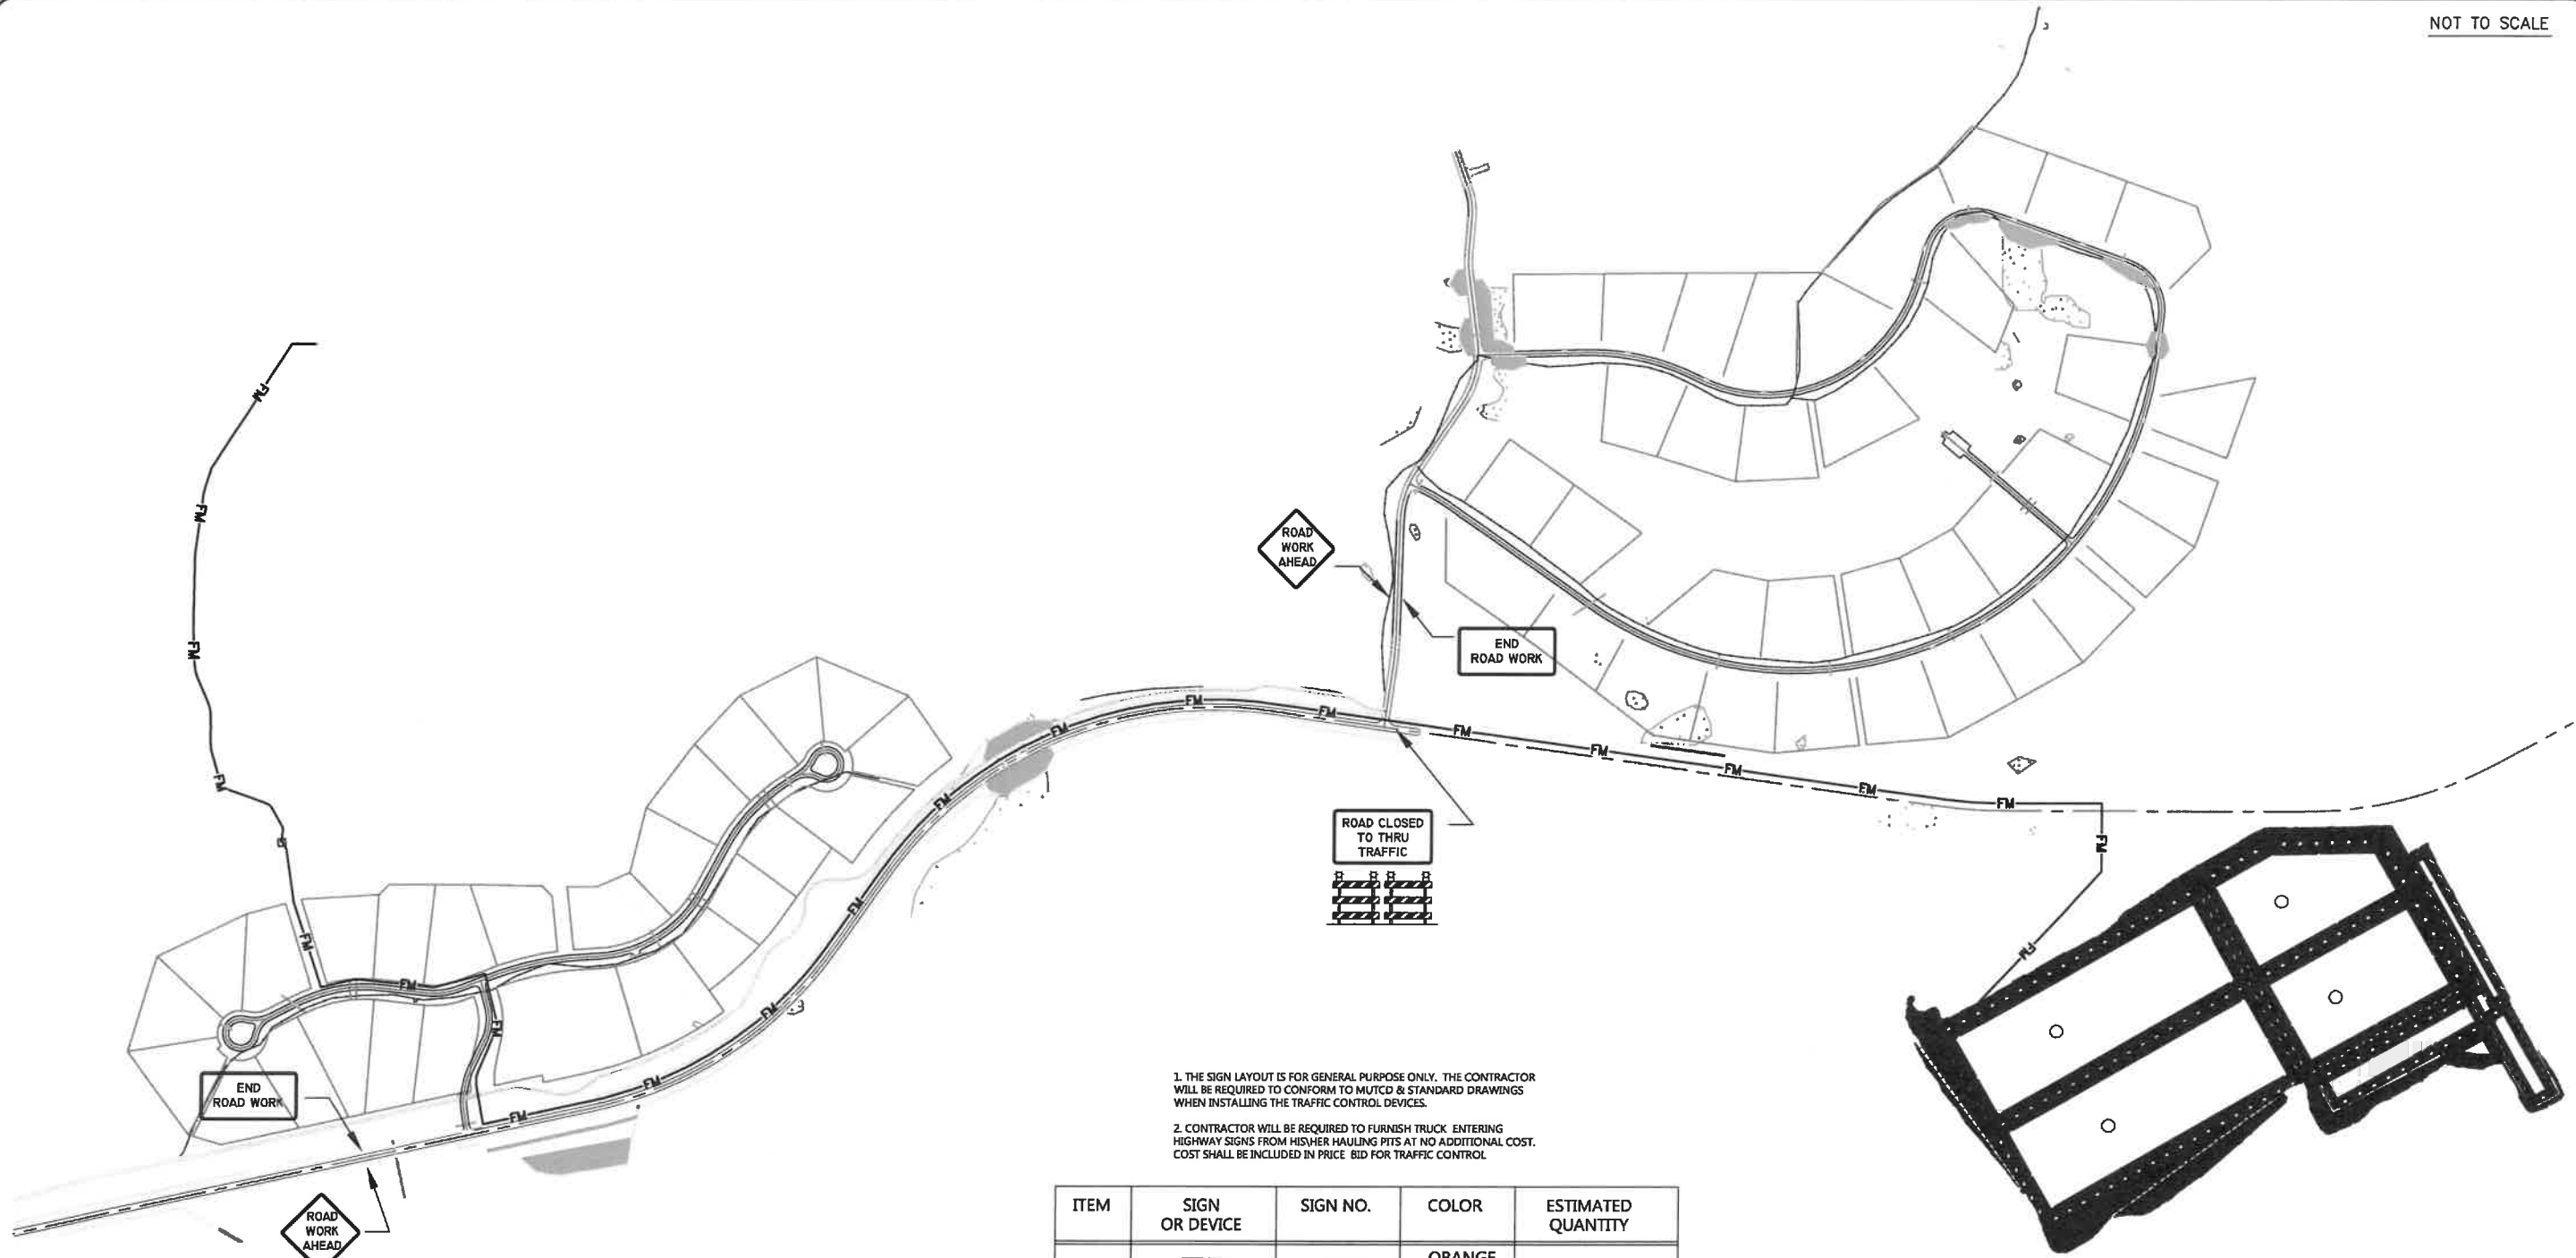

1. THE SIGN LAYOUT IS FOR GENERAL PURPOSE ONLY. THE CONTRACTOR WILL BE REQUIRED TO CONFORM TO MUTCD & STANDARD DRAWINGS WHEN INSTALLING THE TRAFFIC CONTROL DEVICES.

2. CONTRACTOR WILL BE REQUIRED TO FURNISH TRUCK ENTERING HIGHWAY SIGNS FROM HIS/HER HAULING PITS AT NO ADDITIONAL COST. COST SHALL BE INCLUDED IN PRICE BID FOR TRAFFIC CONTROL.

ITEM	SIGN OR DEVICE	SIGN NO.	COLOR	ESTIMATED QUANTITY
1		TYPE III BARRICADE	ORANGE ON WHITE	2
2		R11-4	BLACK ON WHITE	1
3		W20-1	BLACK ON ORANGE	2
4		G20-2A	BLACK ON ORANGE	2
5		TYPE A	YELLOW	4

RED LAKE WASTEWATER FACILITIES
TRAFFIC CONTROL SHEET
RED LAKE RESERVATION, MINNESOTA

JOB NO. 03-42
DATE: 03-29-2011

SHEET NO.
07 OF 27


NORTHERN FACILITIES
CONSULTING, INC.
207 4th Street NW, Bemidji, MN 56601
Phone: 218-444-1860, Fax: 218-444-6042
web: www.nfc-usa.com

I HEREBY CERTIFY THAT THIS PLAN, SPECIFICATION OR REPORT WAS PREPARED BY ME OR UNDER MY CLOSE PERSONAL SUPERVISION AND THAT I AM A LICENSED PROFESSIONAL ENGINEER UNDER THE LAWS OF THE STATE OF MINNESOTA.

Michael C. McFarlane
MICHAEL C. MCFARLANE REG. NO. 44198

REVISIONS:	NO.	DATE	DESCRIPTION	BY
AS-BUILT				

S:\NEC\Projects\03-42-r1 waste water (bigoon)\03-42 AS-BUILT\SDwg\03-42 main.dwg, Sheet 8, 3/29/2011 10:55:40 AM, snopl

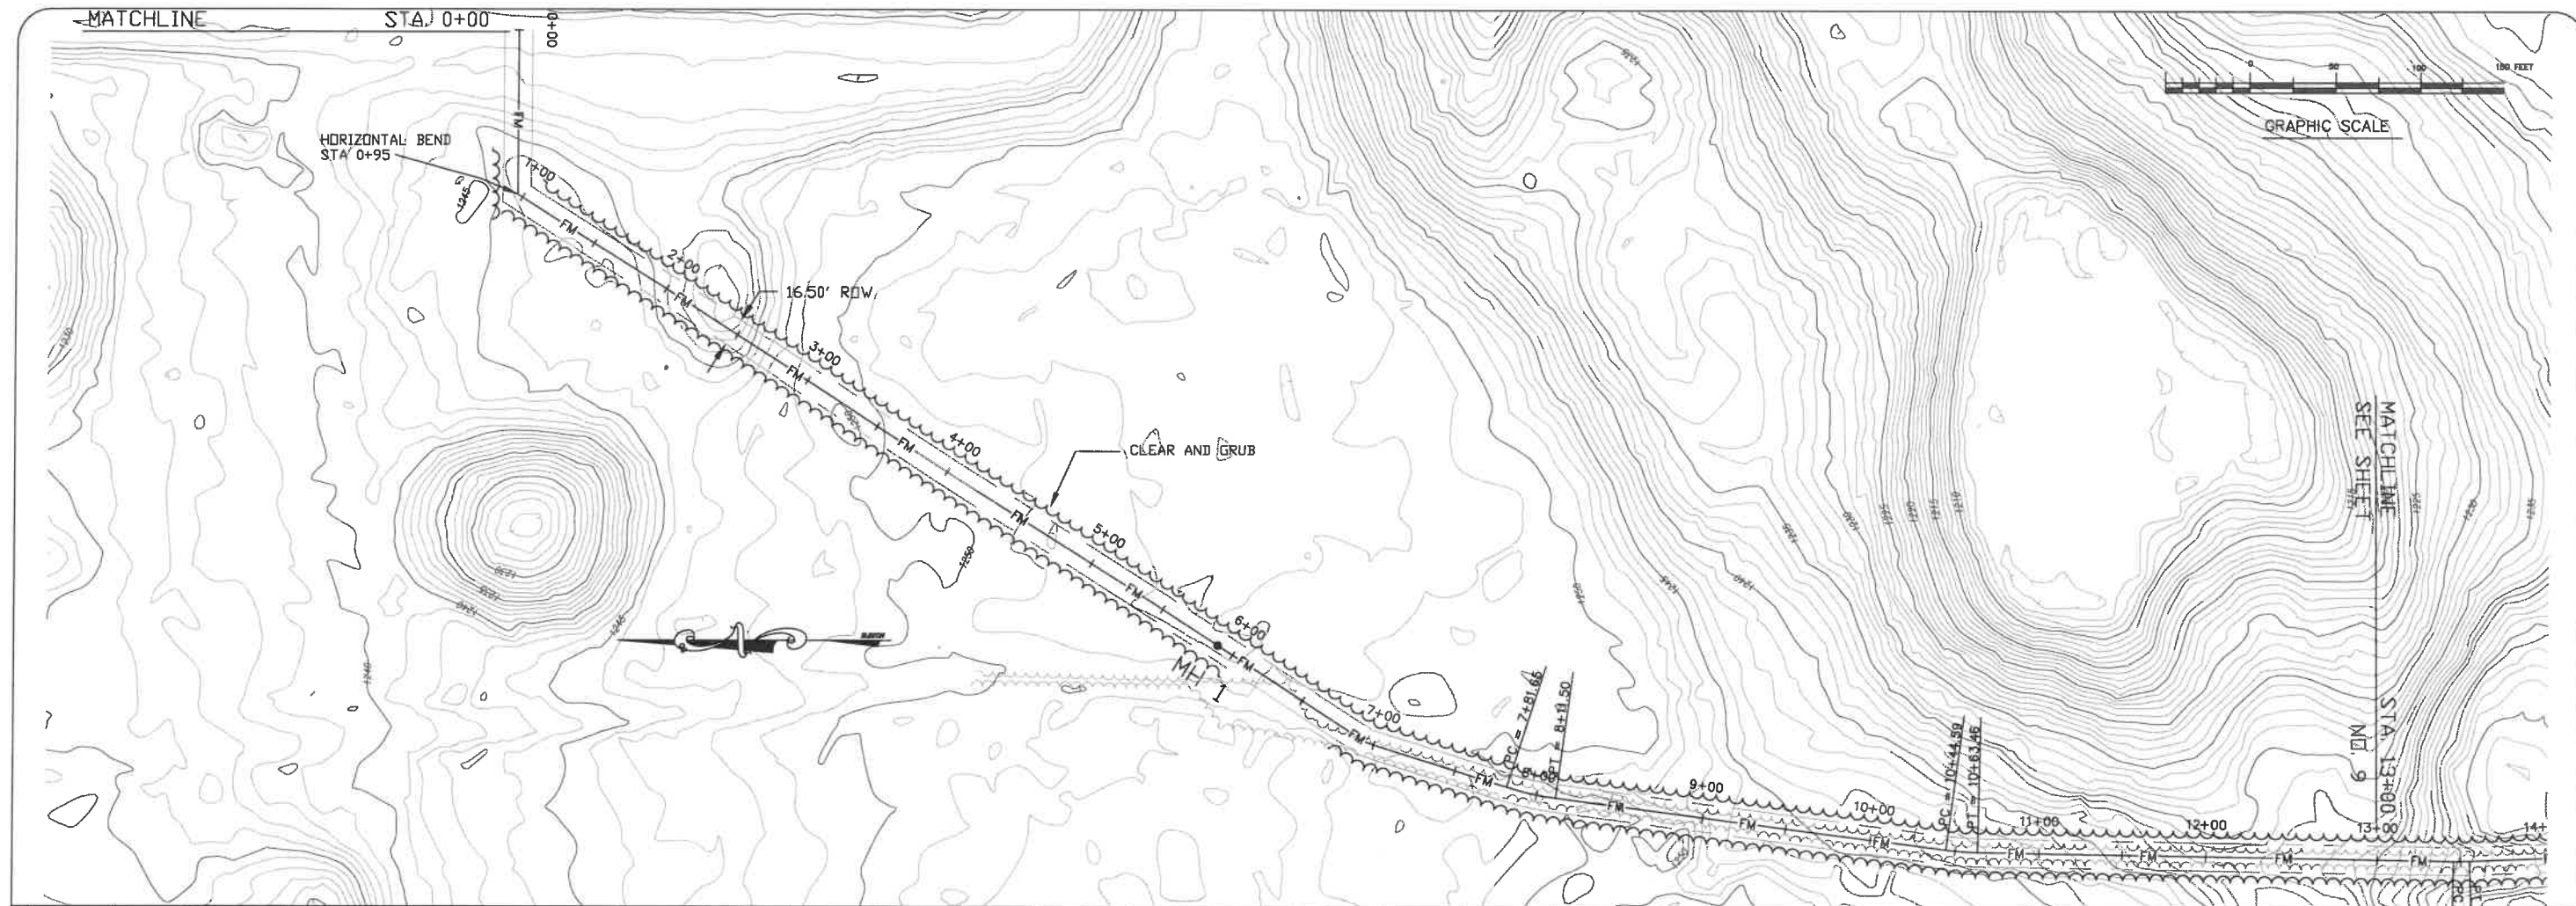

REVISIONS		NO.	DATE	DESCRIPTION	BY
AS-BUILT					

I HEREBY CERTIFY THAT THIS PLAN, SPECIFICATION OR REPORT WAS PREPARED BY ME OR UNDER MY CLOSE PERSONAL SUPERVISION AND THAT I AM A LICENSED PROFESSIONAL ENGINEER UNDER THE LAWS OF THE STATE OF MINNESOTA.



Michael C. McFarlane
MICHAEL C. MCFARLANE
REG. NO. 44186



RED LAKE WASTEWATER FACILITIES
PLAN AND PROFILE
RED LAKE RESERVATION, MINNESOTA

JOB NO. 03-42
DATE: 03-29-2011
SHEET NO.
08 OF 27

S:\NEC\Projects\03-42 r1 waste water (lagoon)\03-42 AS-BUILT\DWG\03-42main.dwg, Sheet 9, 3/29/2011 10:36:10 AM, snopl

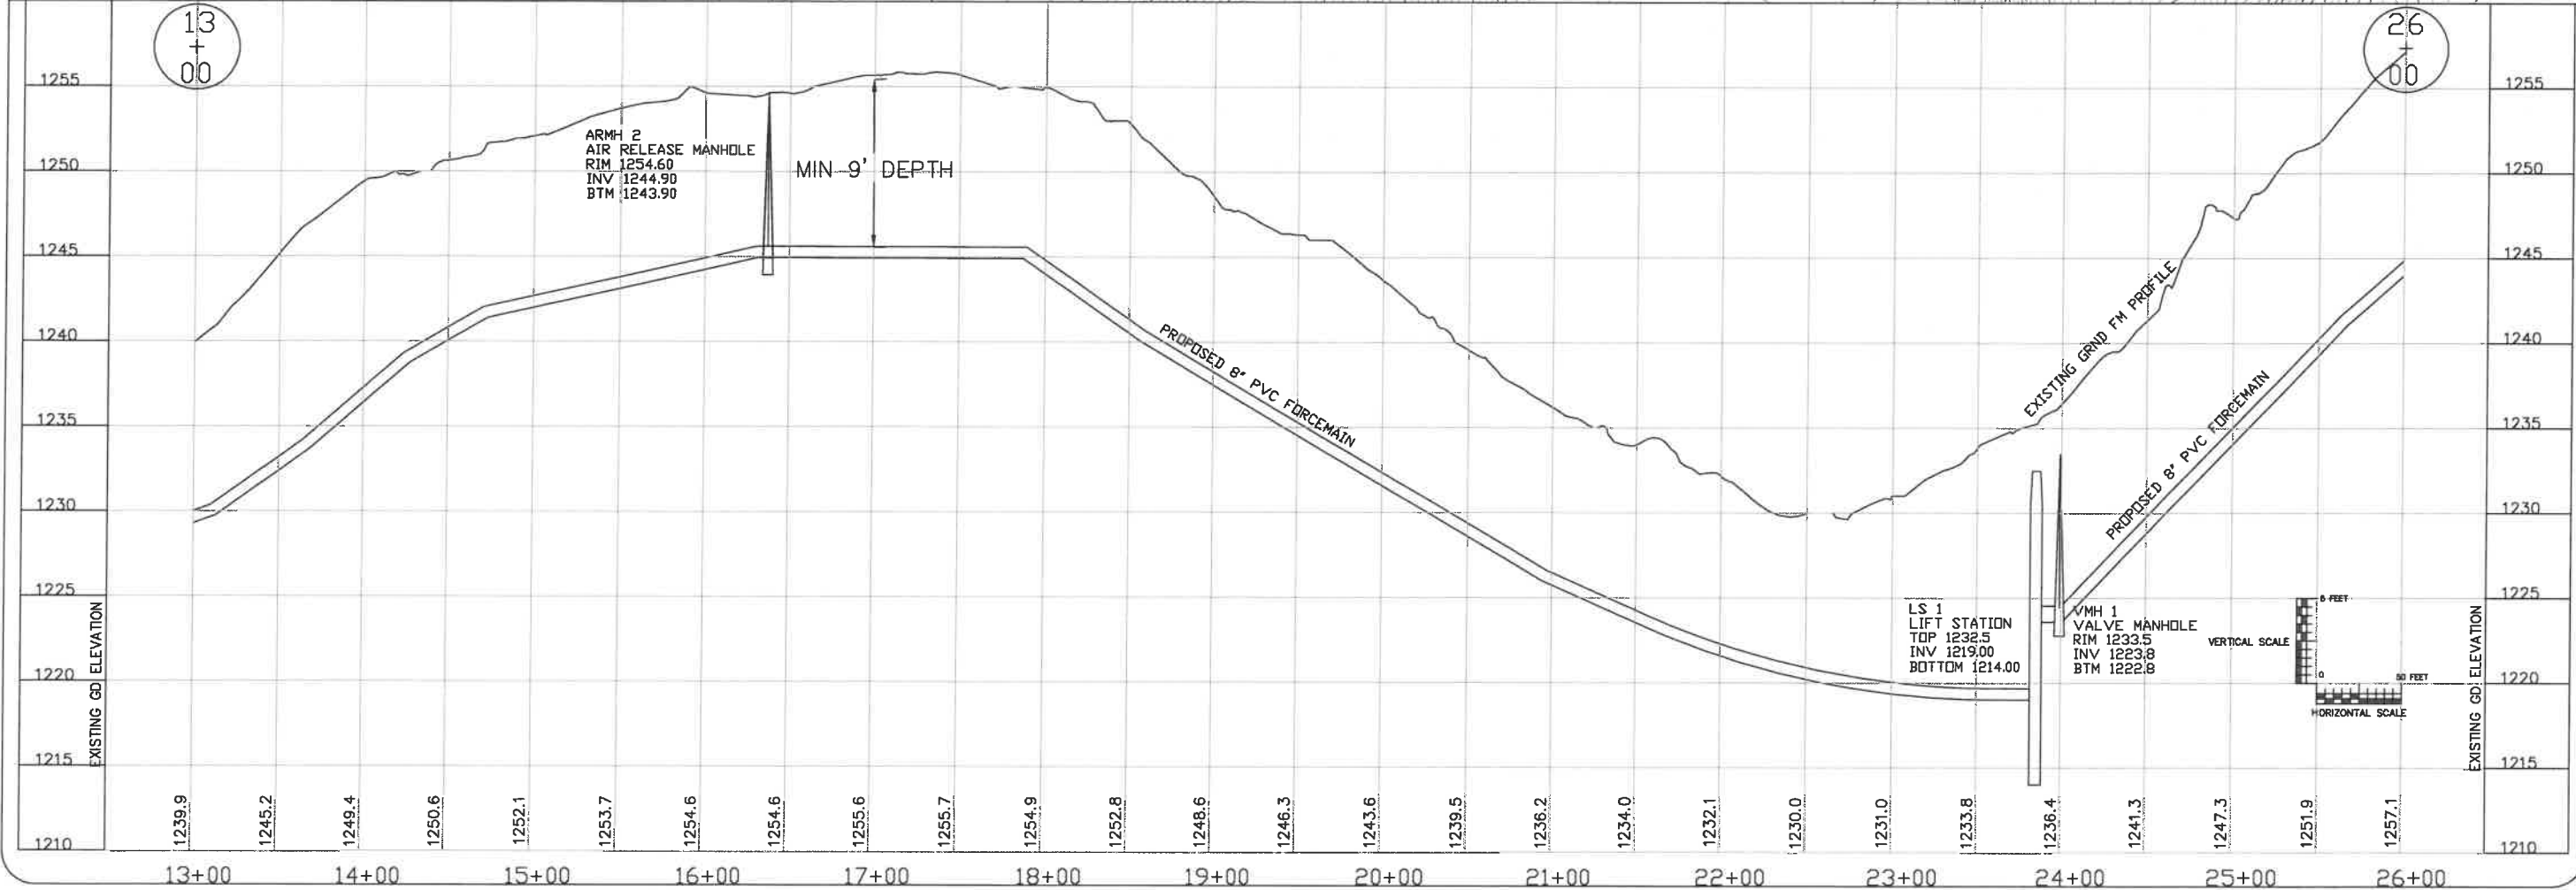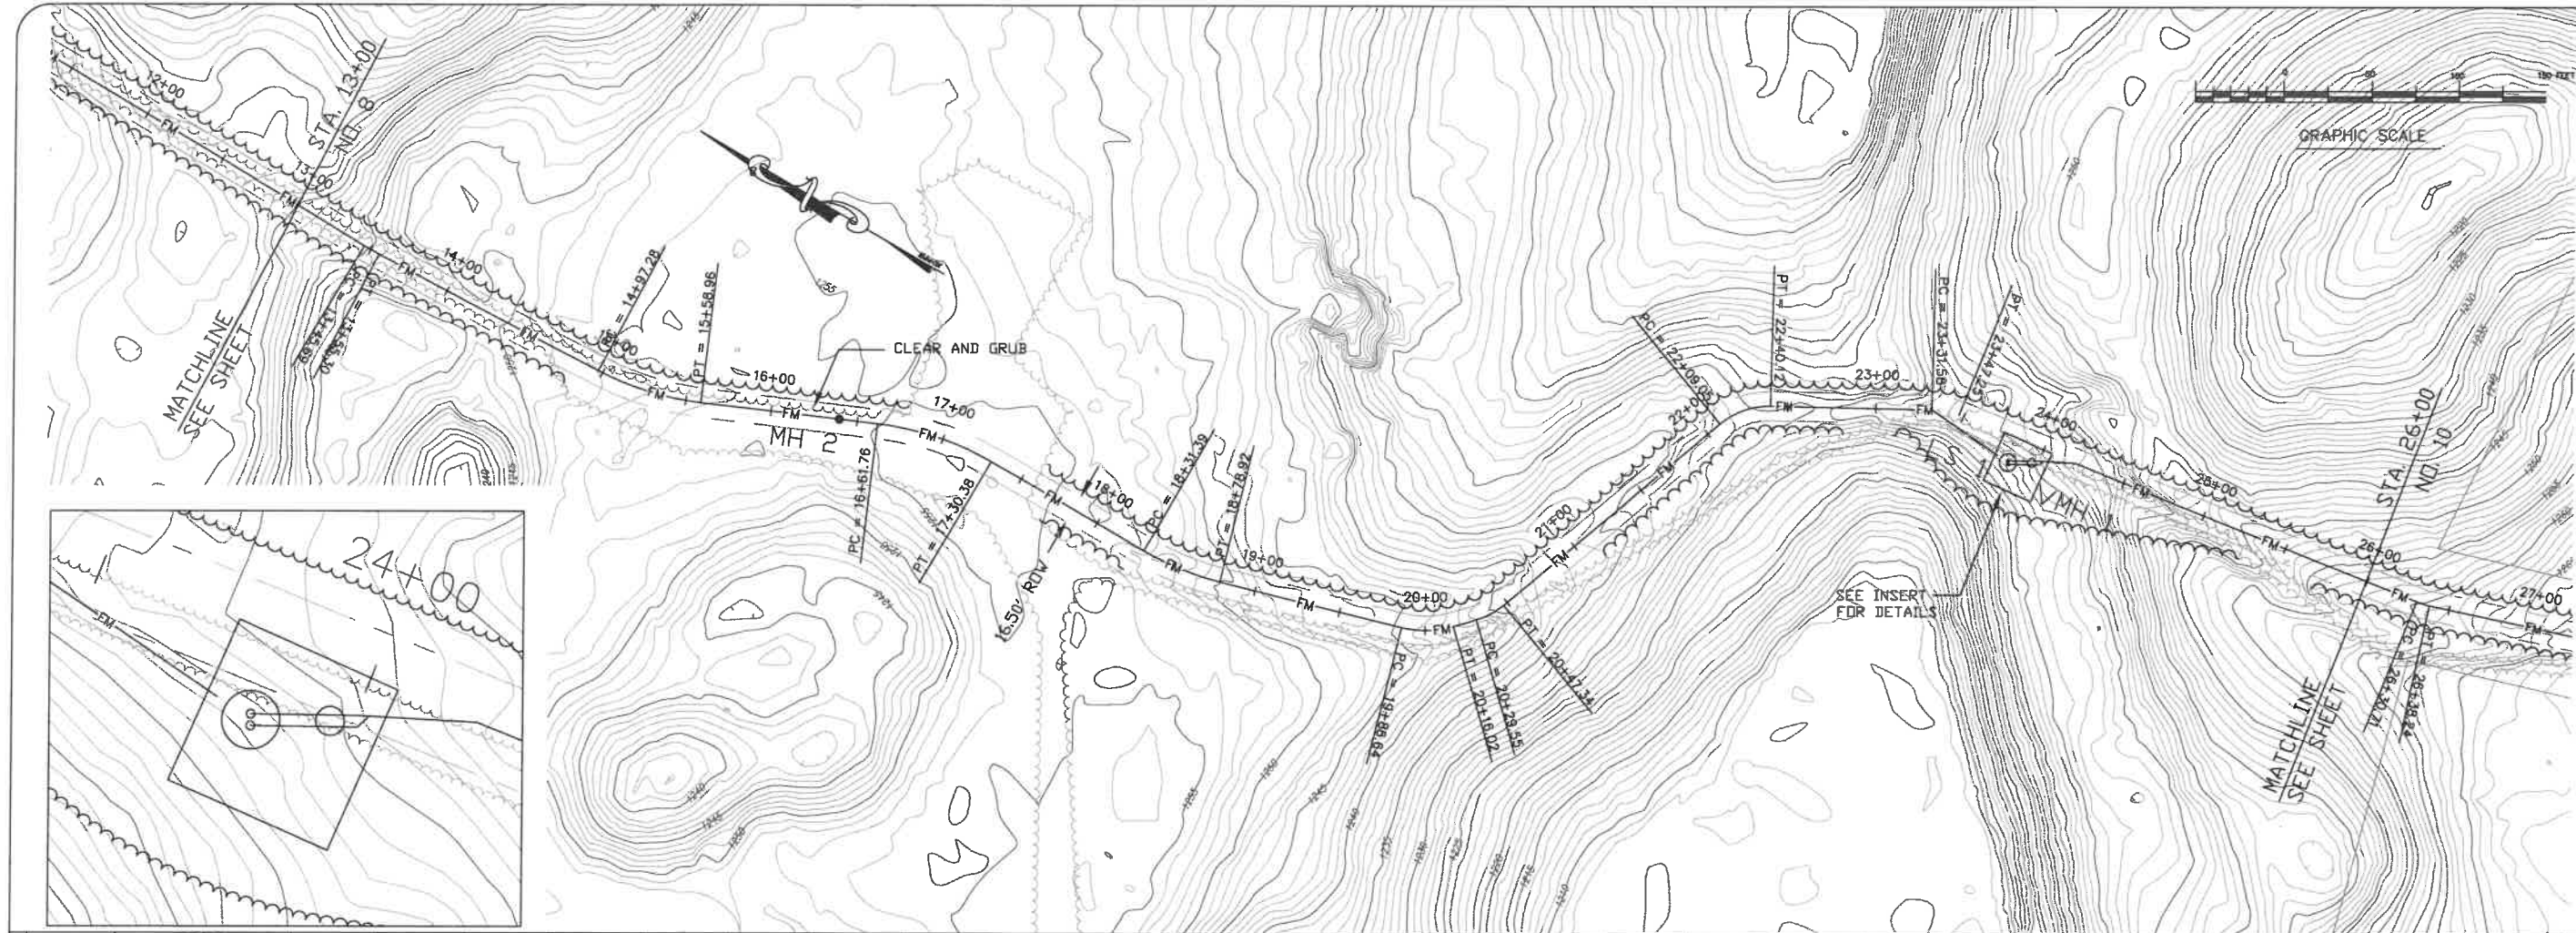

REVISIONS:	NG.	DATE	DESCRIPTION	BY
AS-BUILT				

I HEREBY CERTIFY THAT THIS PLAN, SPECIFICATION OR REPORT WAS PREPARED BY ME OR UNDER MY CLOSE PERSONAL SUPERVISION AND THAT I AM A LICENSED PROFESSIONAL ENGINEER UNDER THE LAWS OF THE STATE OF MINNESOTA.


Michael C. McFarlane
MICHAEL C. MCFARLANE
REG. NO. 44106





RED LAKE WASTEWATER FACILITIES
PLAN AND PROFILE
RED LAKE RESERVATION, MINNESOTA

JOB NO. 03-42
DATE: 03-29-2011

SHEET NO.
09 OF 27

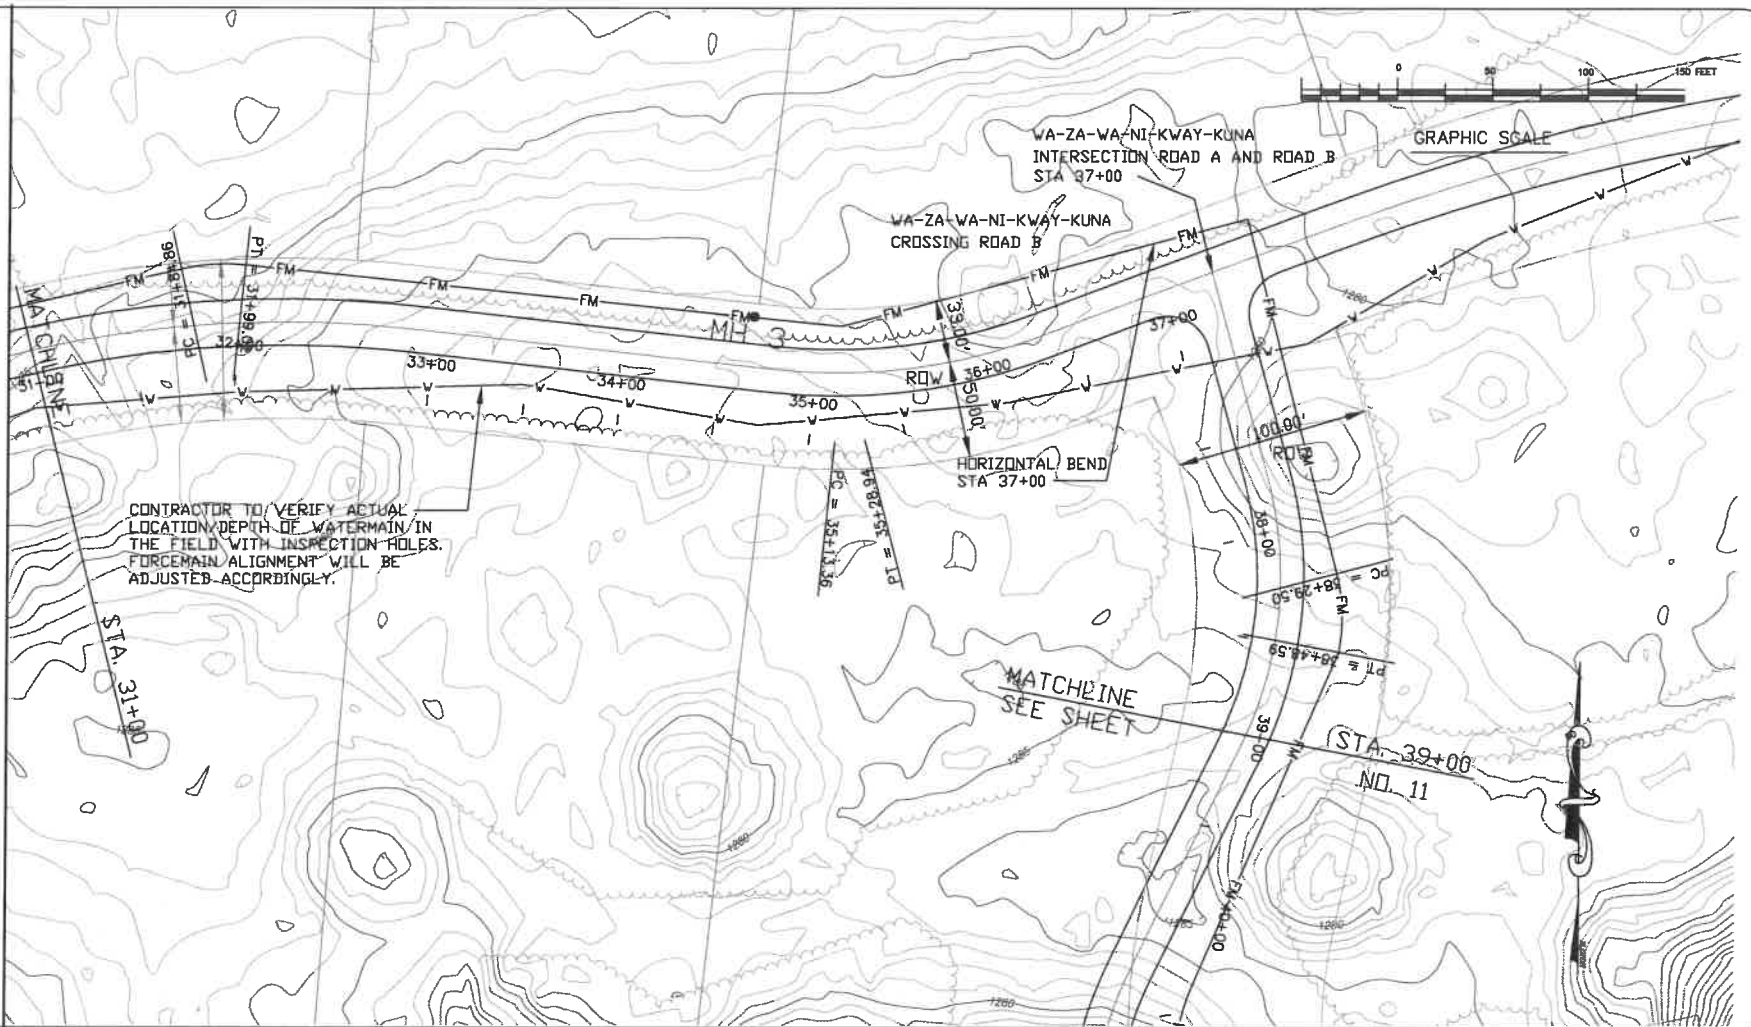

S:\NEC\Projects\03-42-ri waste water (bigoon)\03-42 AS-BUILTS.dwg\03-42main.dwg, Sheet 11, 3/29/2011 10:36:40 AM, snopl

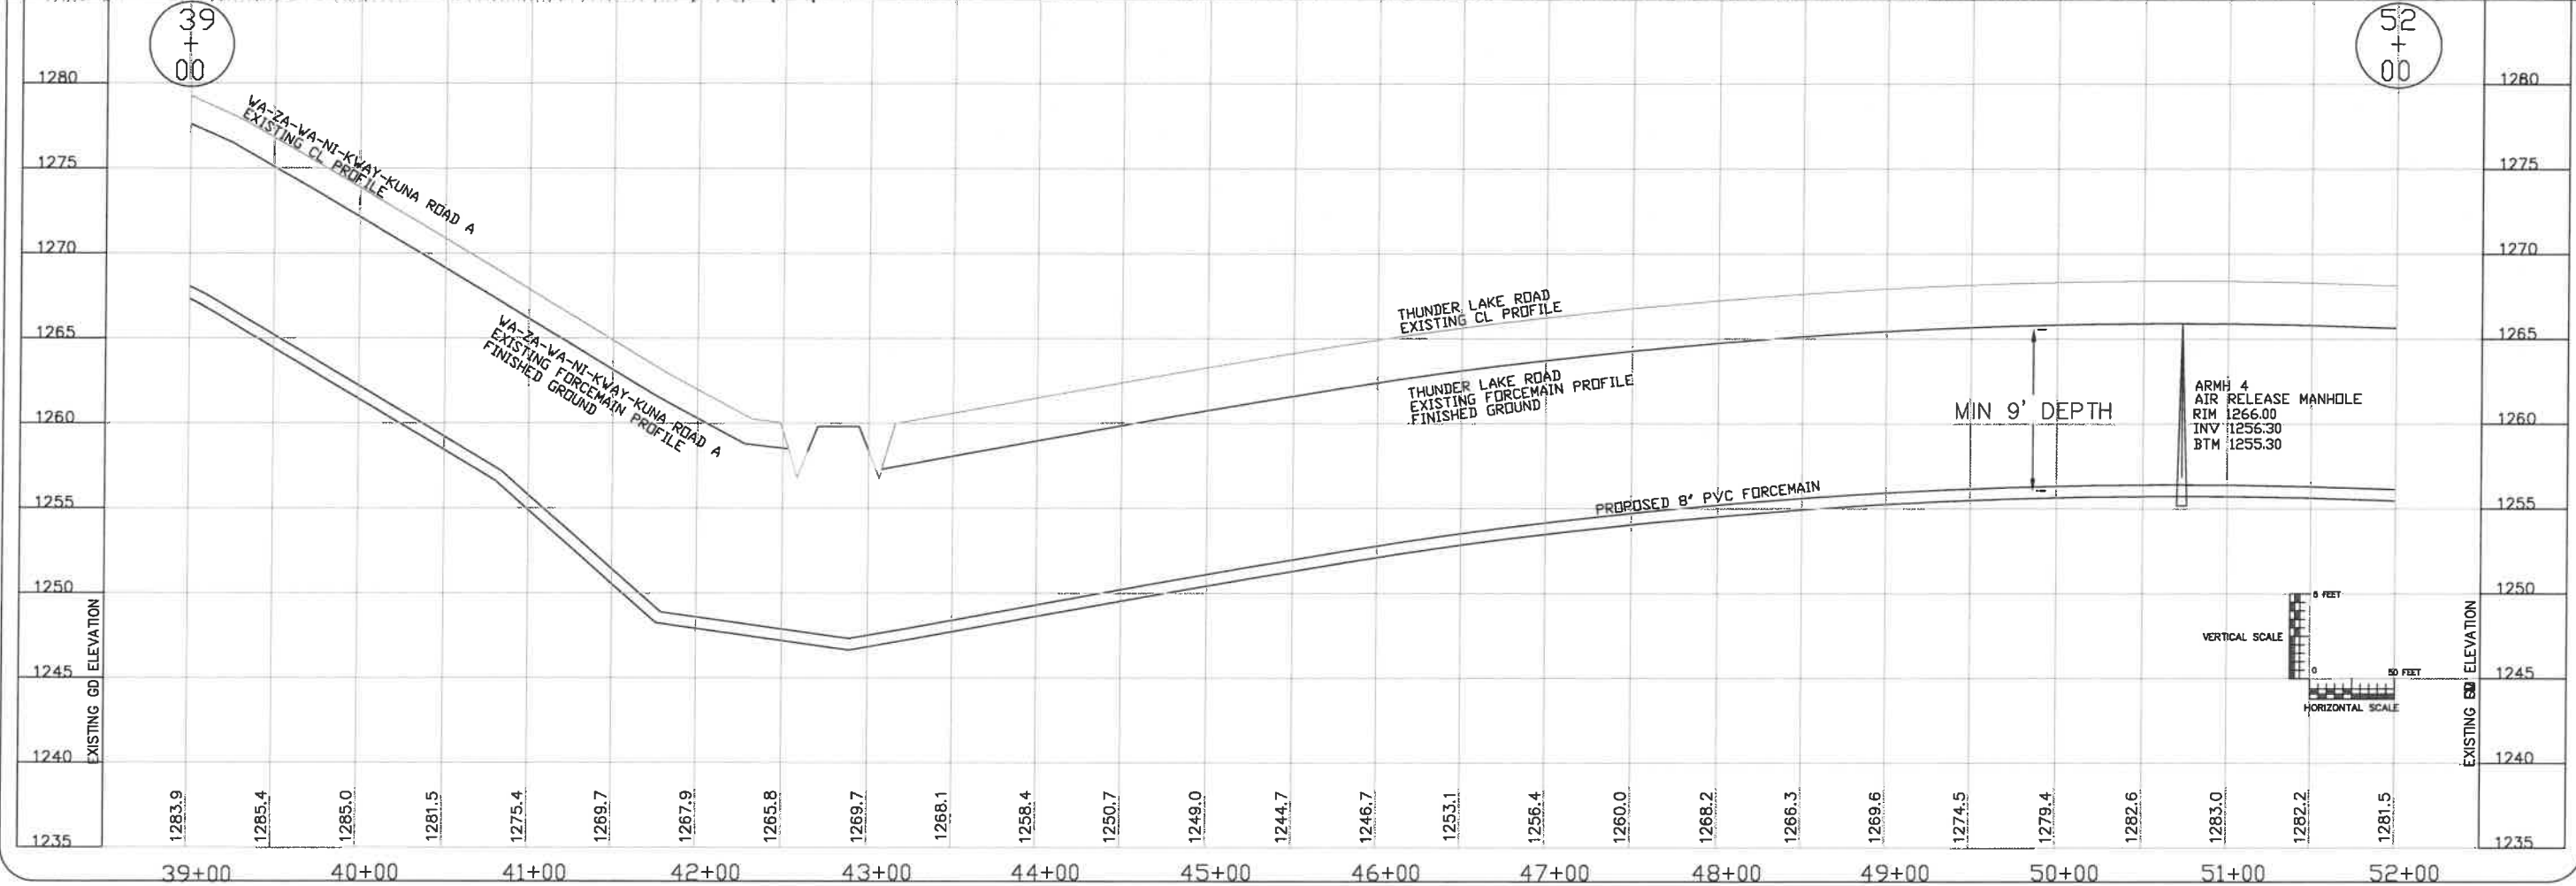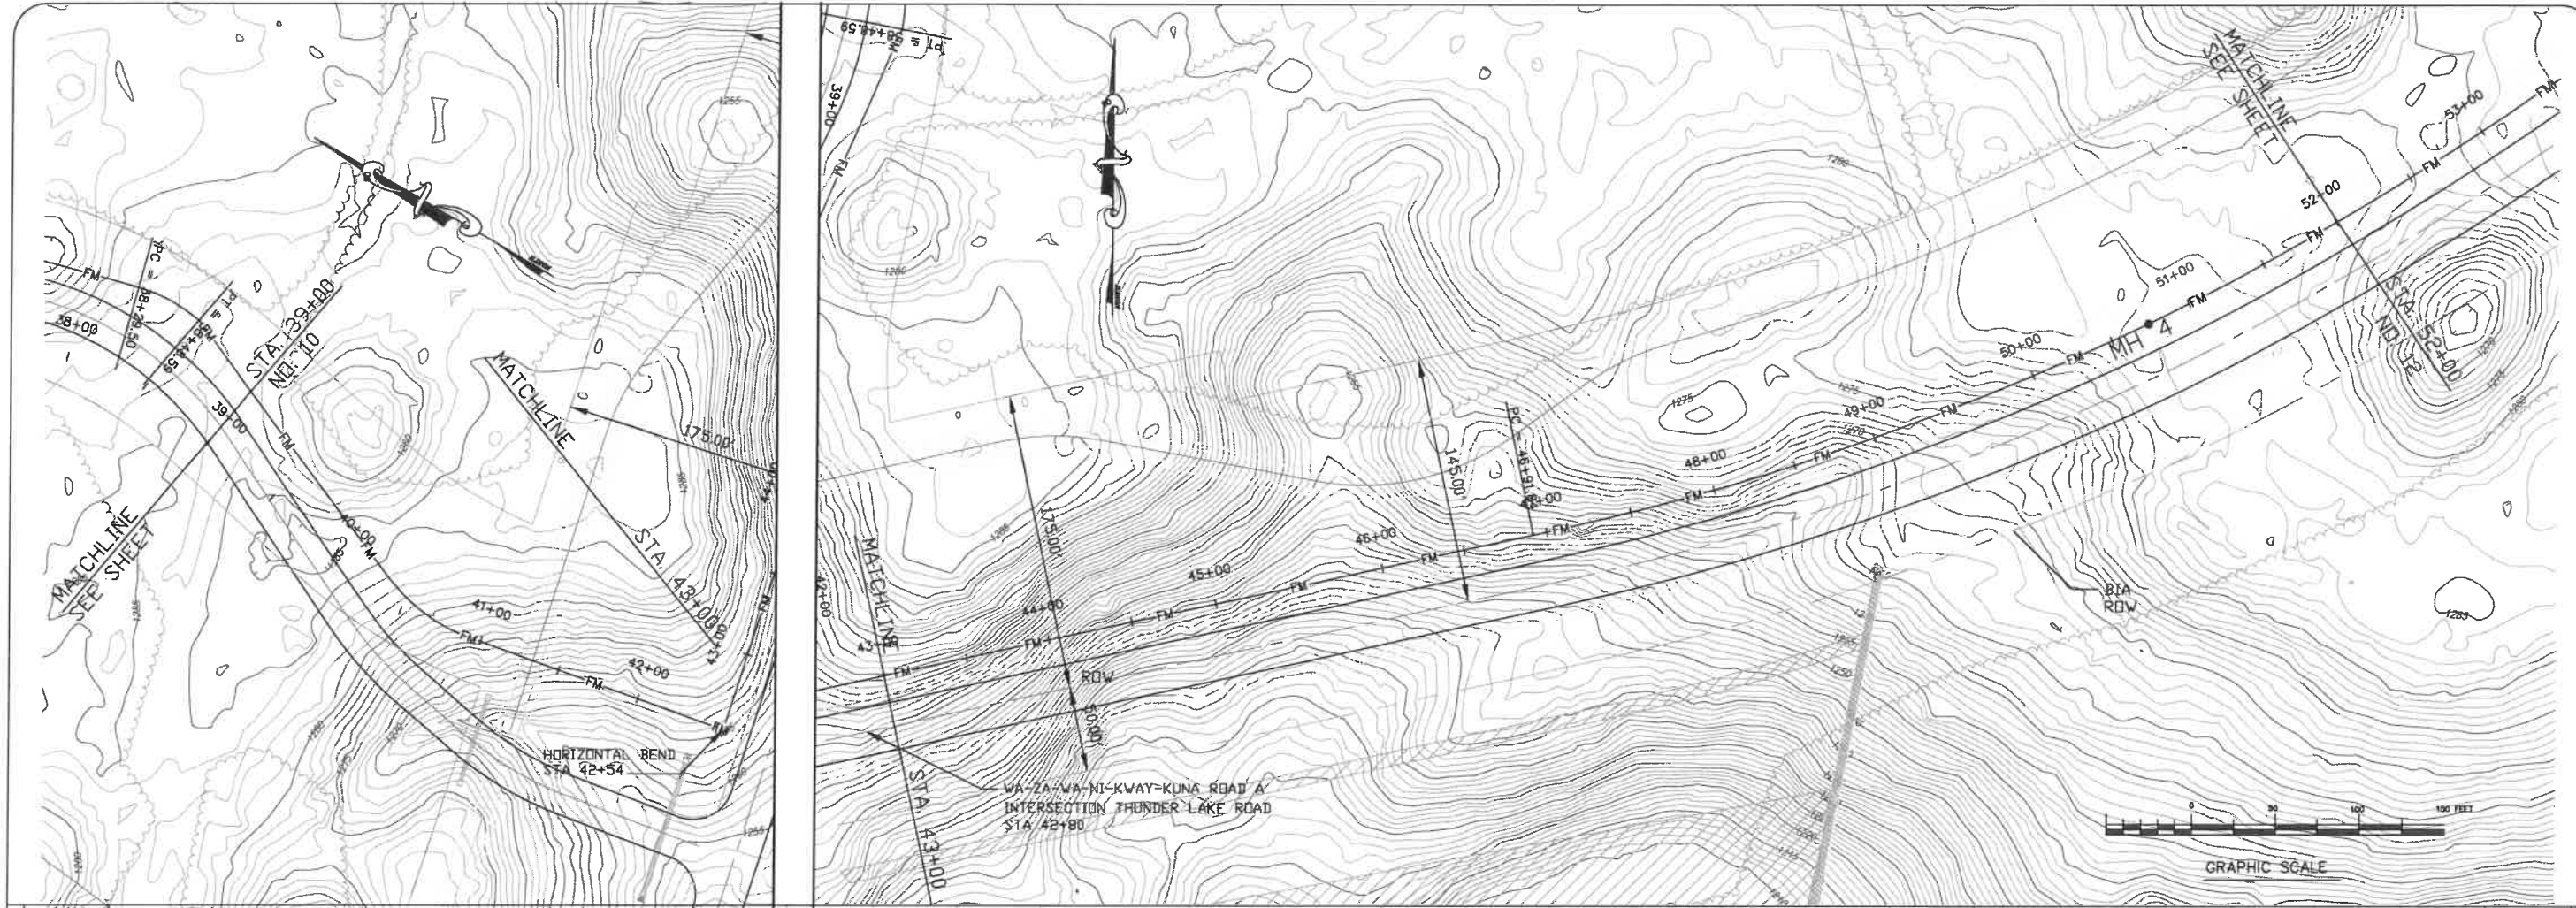

REVISIONS:			
NO.	DATE	DESCRIPTION	BY
AS-BUILT			



I HEREBY CERTIFY THAT THIS PLAN, SPECIFICATION OR REPORT WAS PREPARED BY ME OR UNDER MY DIRECT SUPERVISION AND THAT I AM A DULY LICENSED PROFESSIONAL ENGINEER UNDER THE LAWS OF THE STATE OF MINNESOTA.

Michael C. McFarlane
MICHAEL C. MCFARLANE REG. NO. 44188



RED LAKE WASTEWATER FACILITIES
PLAN AND PROFILE
RED LAKE RESERVATION, MINNESOTA

S:\NEC\Projects\03-42 rd waste water (bigoon)\03-42 AS-BUILT\TS\dwg\03-42main.dwg, Sheet 12, 3/29/2011 10:36:55 AM, ssnapl

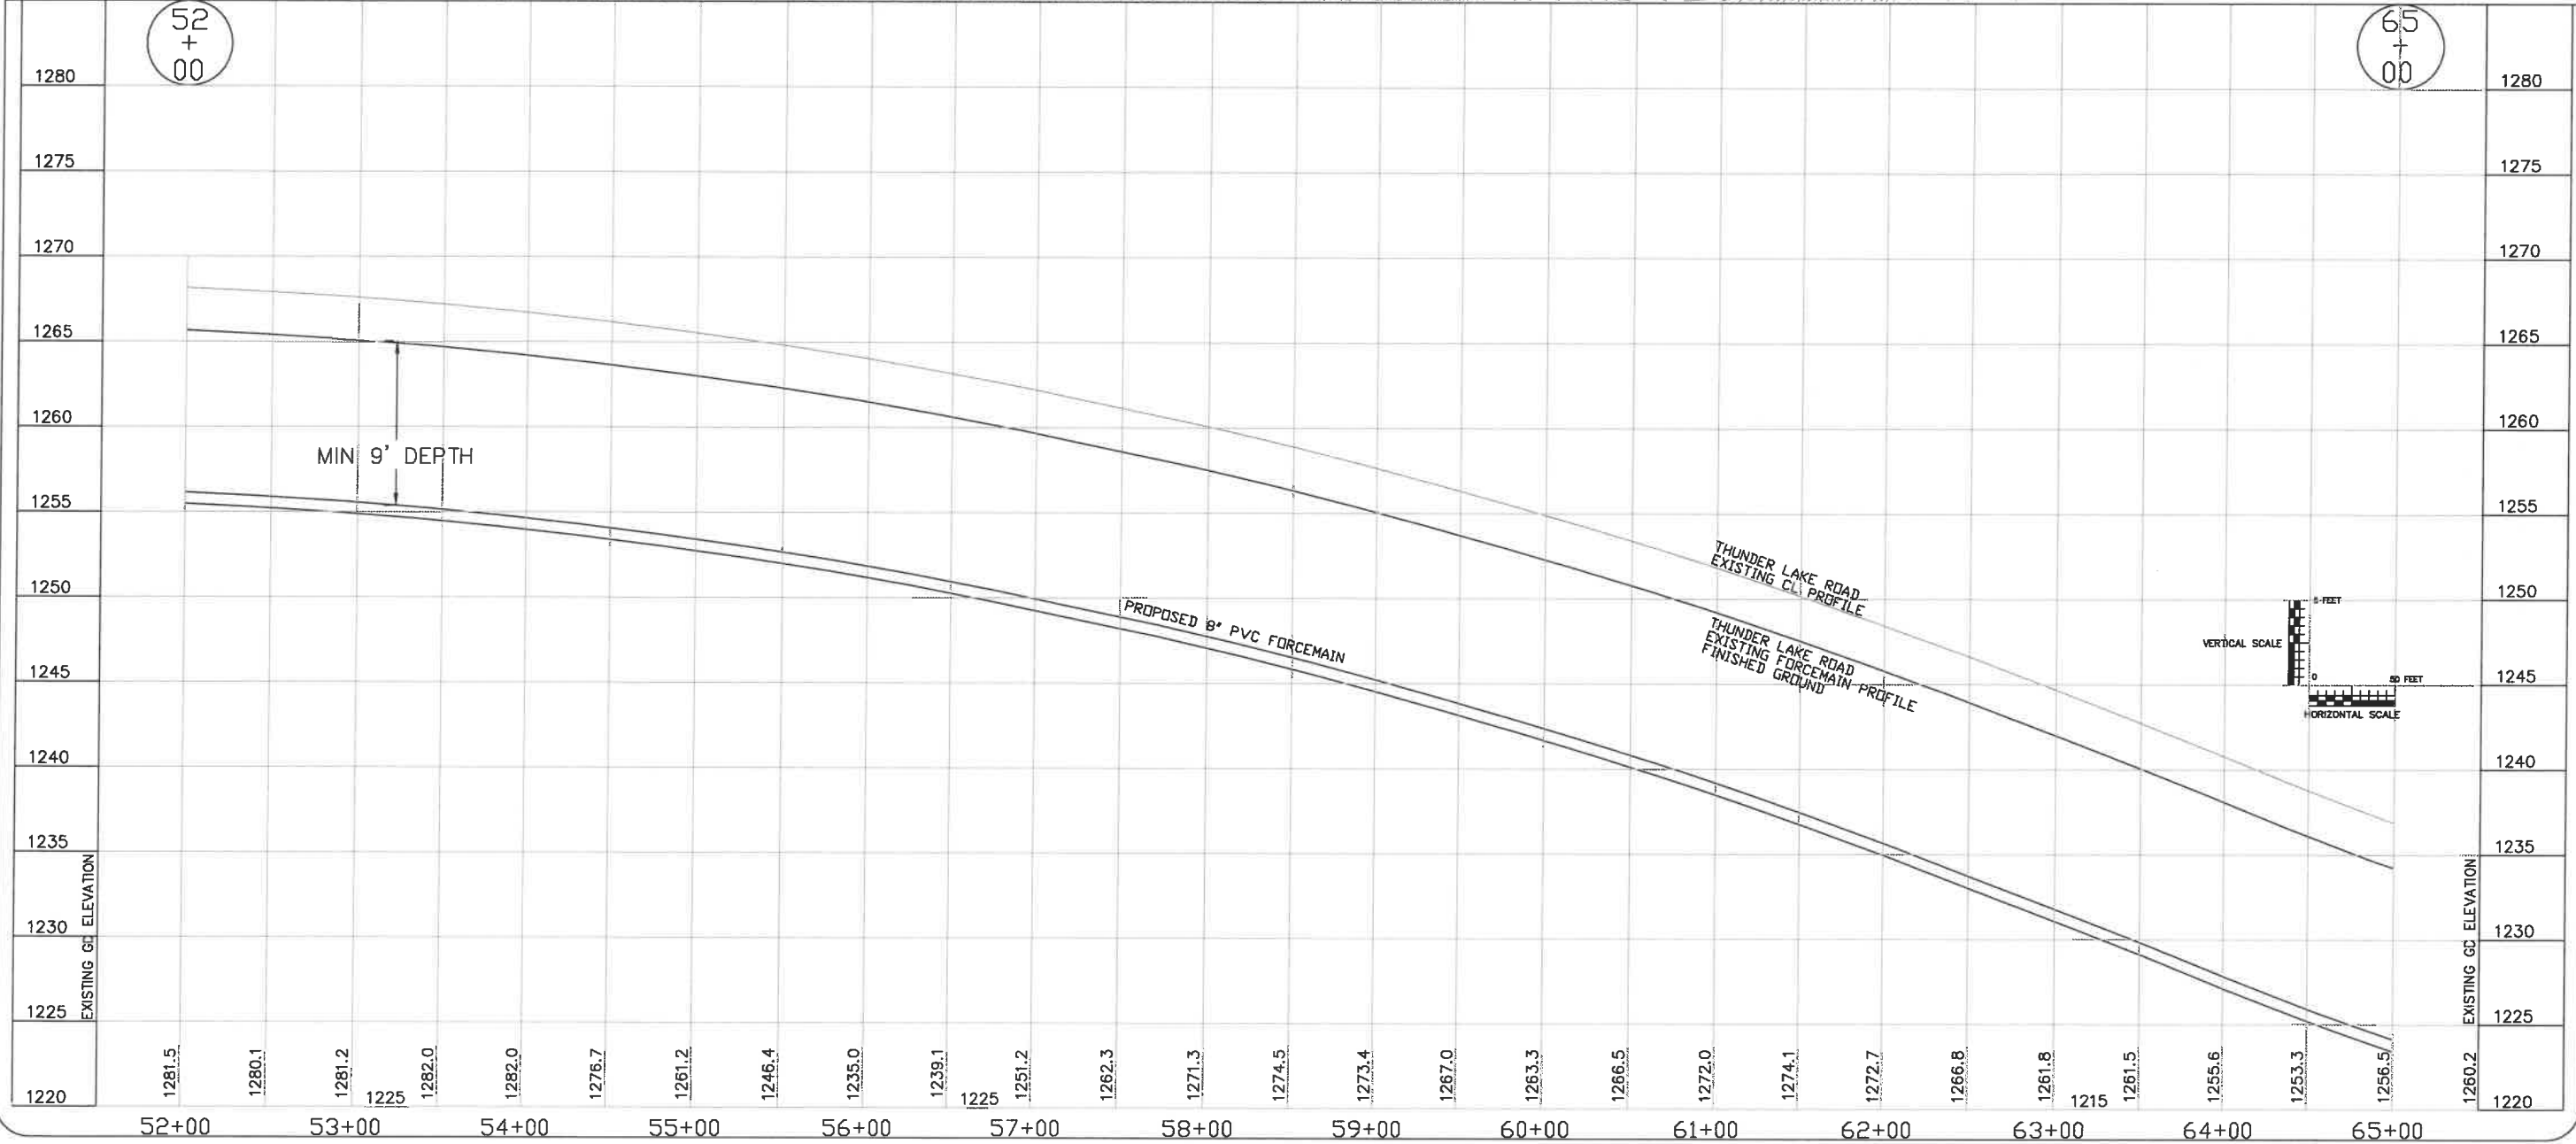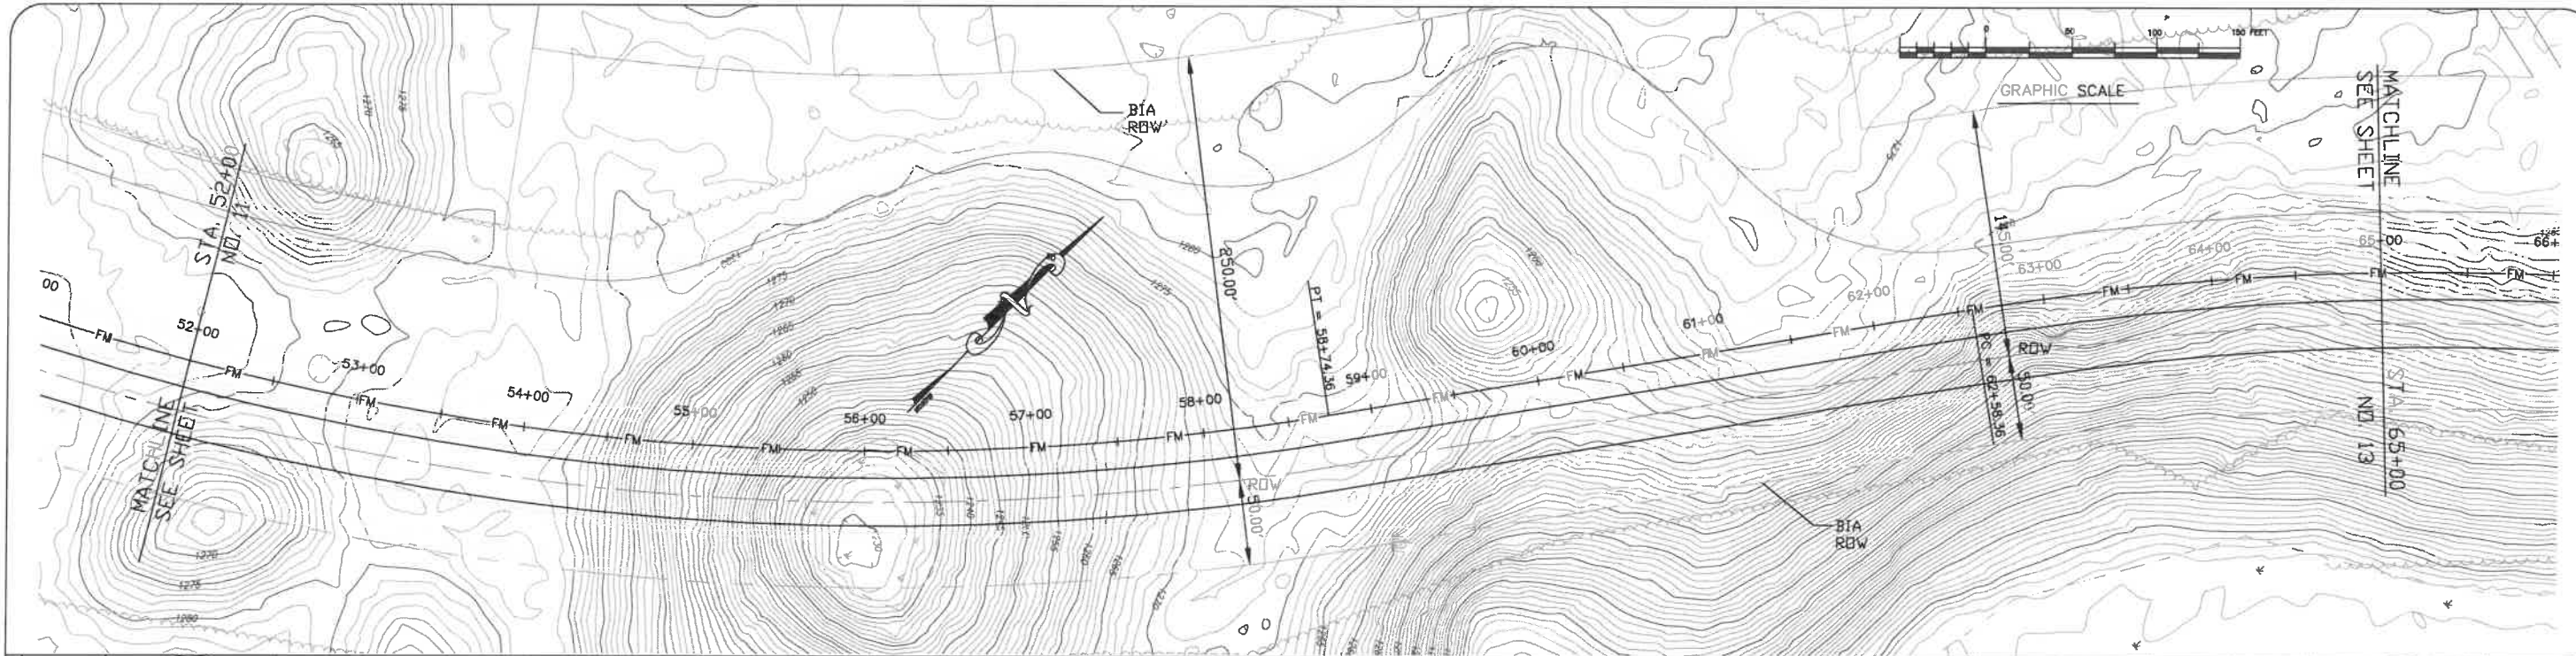

REVISIONS			
NO.	DATE	DESCRIPTION	BY
1		AS-BUILT	

I HEREBY CERTIFY THAT THIS PLAN, SPECIFICATION OR REPORT WAS PREPARED BY ME OR UNDER MY CLOSE PERSONAL SUPERVISION AND I AM A DULY LICENSED PROFESSIONAL ENGINEER UNDER THE LAWS OF THE STATE OF MINNESOTA.



Michael C. McFarlane
MICHAEL C. MCFARLANE REG. NO. 44196



RED LAKE WASTEWATER FACILITIES
PLAN AND PROFILE
RED LAKE RESERVATION, MINNESOTA

JOB NO. 03-42
DATE: 06-19-2009
SHEET NO. 12 OF 27

S:\MEC\Projects\03-42 rl waste water (legoon)\03-42 AS-BUILT\DWG\03-42main.dwg, Sheet 13, 3/29/2011 10:37:06 AM, ssnopl

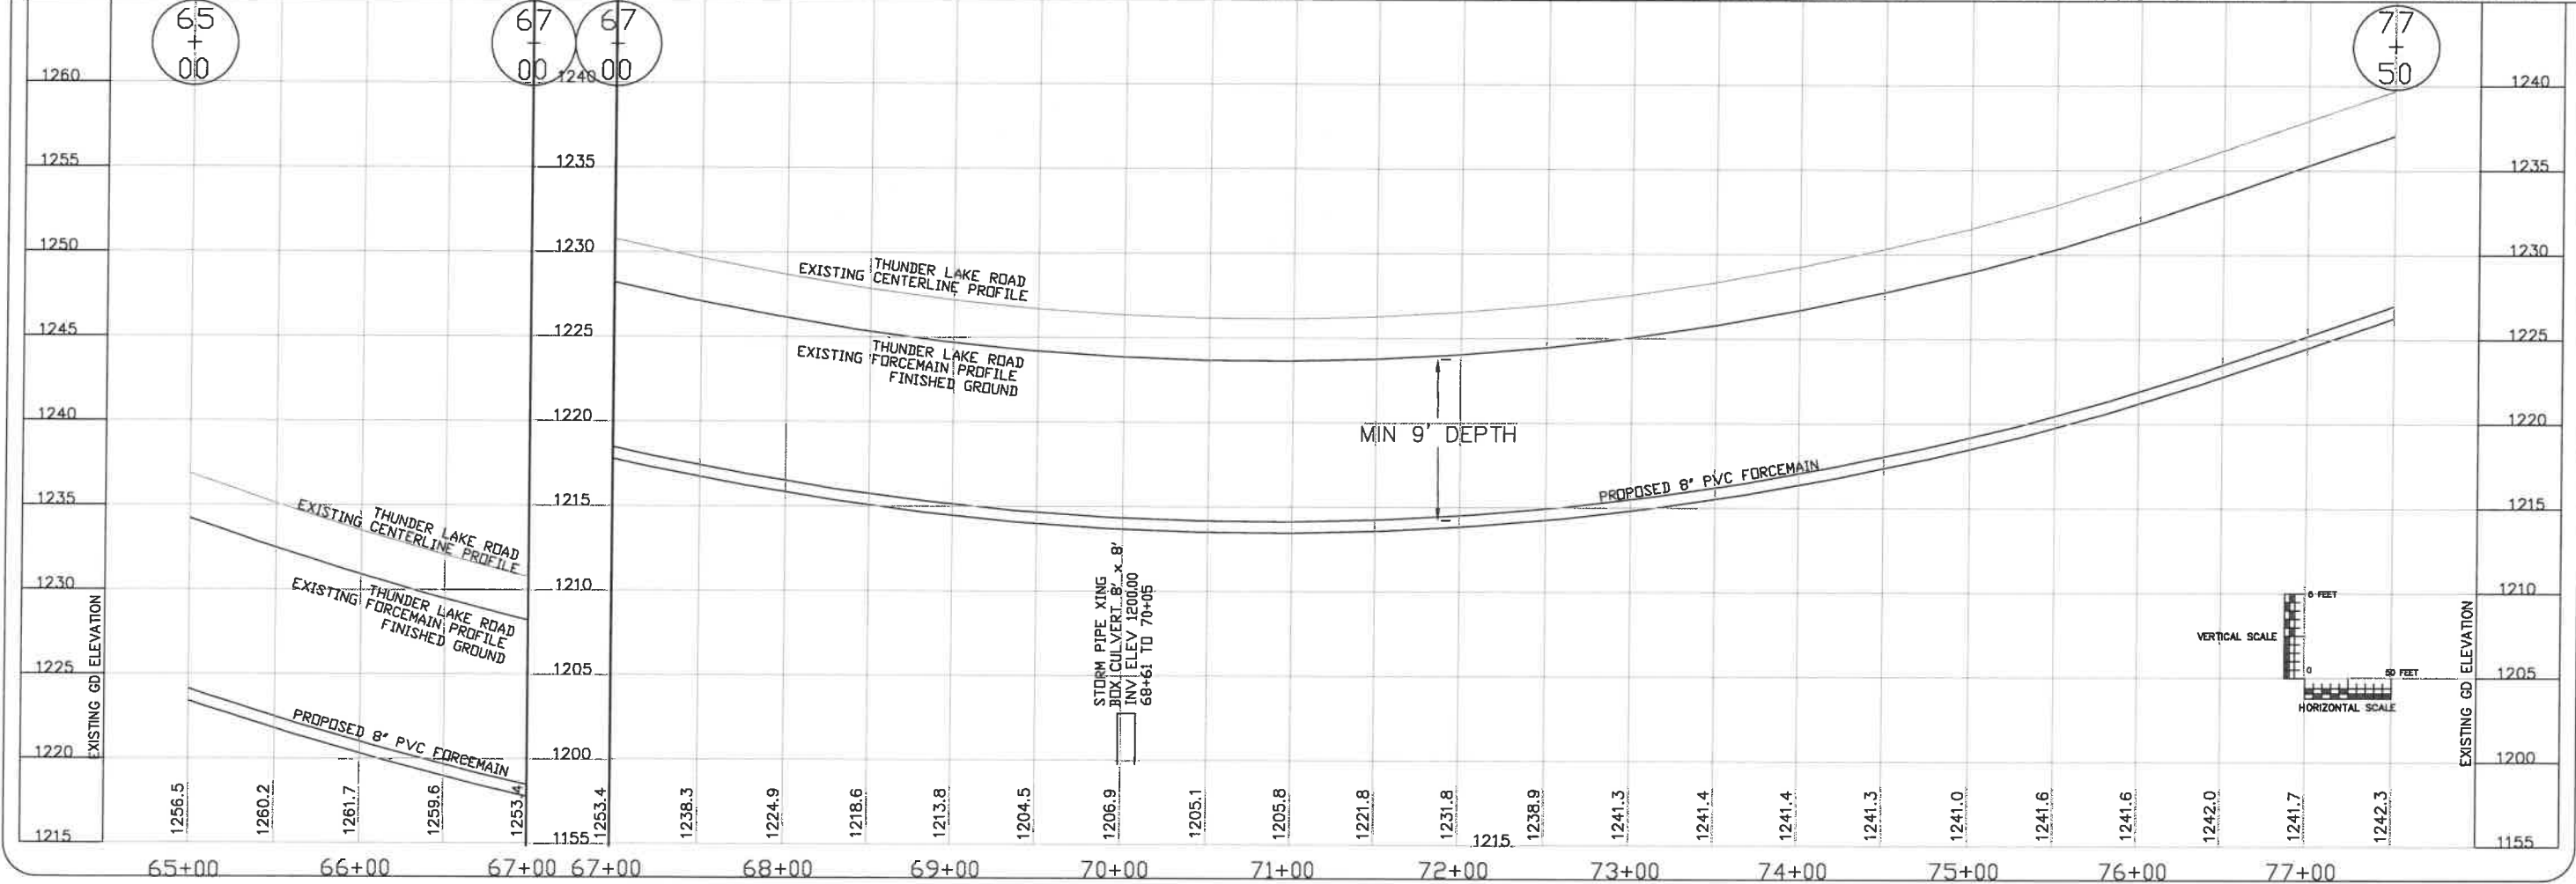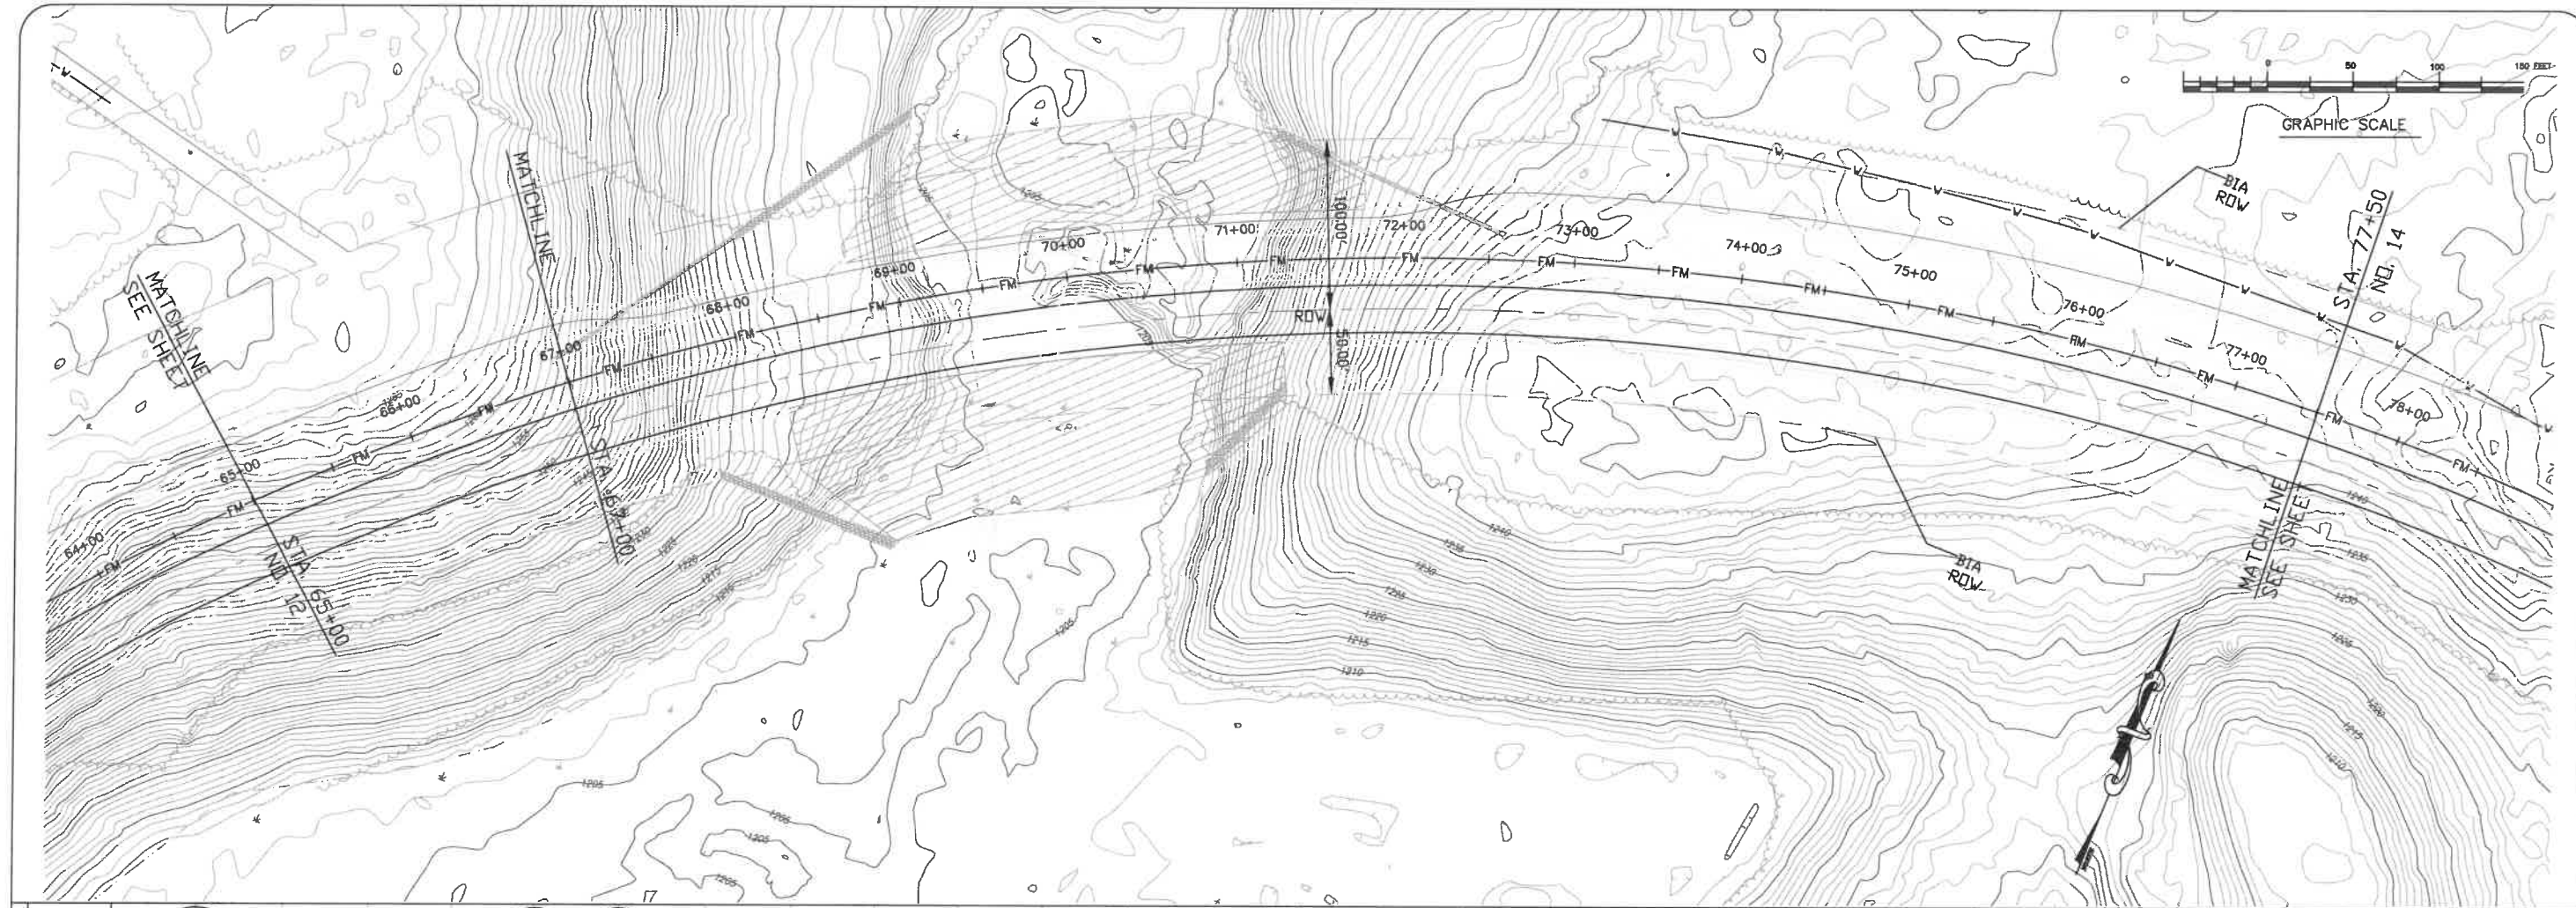

RED LAKE WASTEWATER FACILITIES
PLAN AND PROFILE
RED LAKE RESERVATION, MINNESOTA

JOB NO. 03-42
DATE: 03-29-2011



SHEET NO.
13 OF 27

McFARLANE ENGINEERING & CONSULTING, INC.
207 4th Street NW, Bemidji, MN 56601
Phone: 218-444-4860, Fax: 218-444-6042
web: www.mcfarlane.com

I HEREBY CERTIFY THAT THIS PLAN, SPECIFICATION OR REPORT WAS PREPARED BY ME OR UNDER MY CLOSE PERSONAL SUPERVISION AND THAT I AM A DULY LICENSED PROFESSIONAL ENGINEER UNDER THE LAWS OF THE STATE OF MINNESOTA.
Michael C. McFarlane
MICHAEL C. MCFARLANE REG. NO. 44186

REVISIONS:
AS-BUILT
NO. DATE DESCRIPTION BY

S:\NEC\Projects\03-42 r1 waste water (legoon)\03-42 AS-BUILT\DWG\03-42main.dwg, Sheet 14, 3/29/2011 10:37:20 AM, snopl

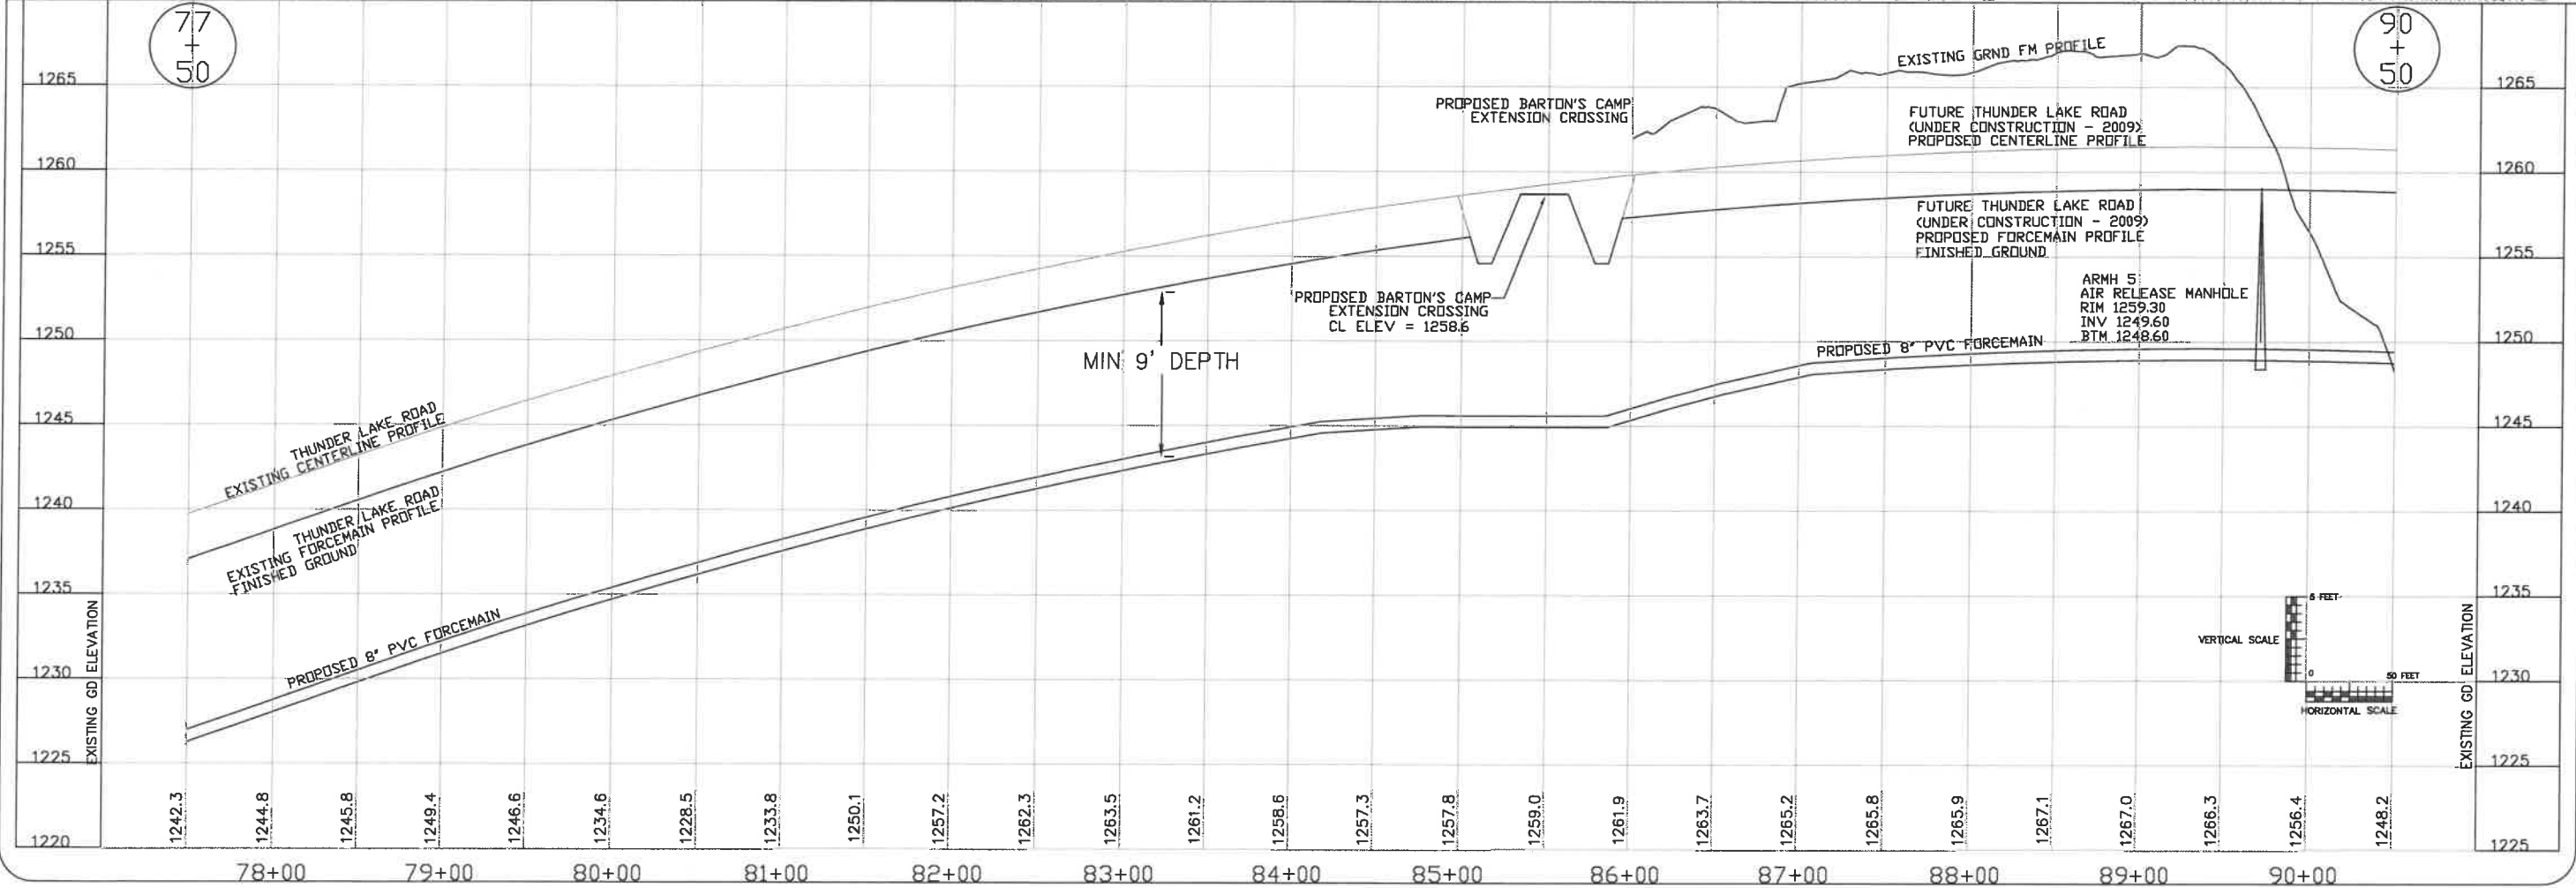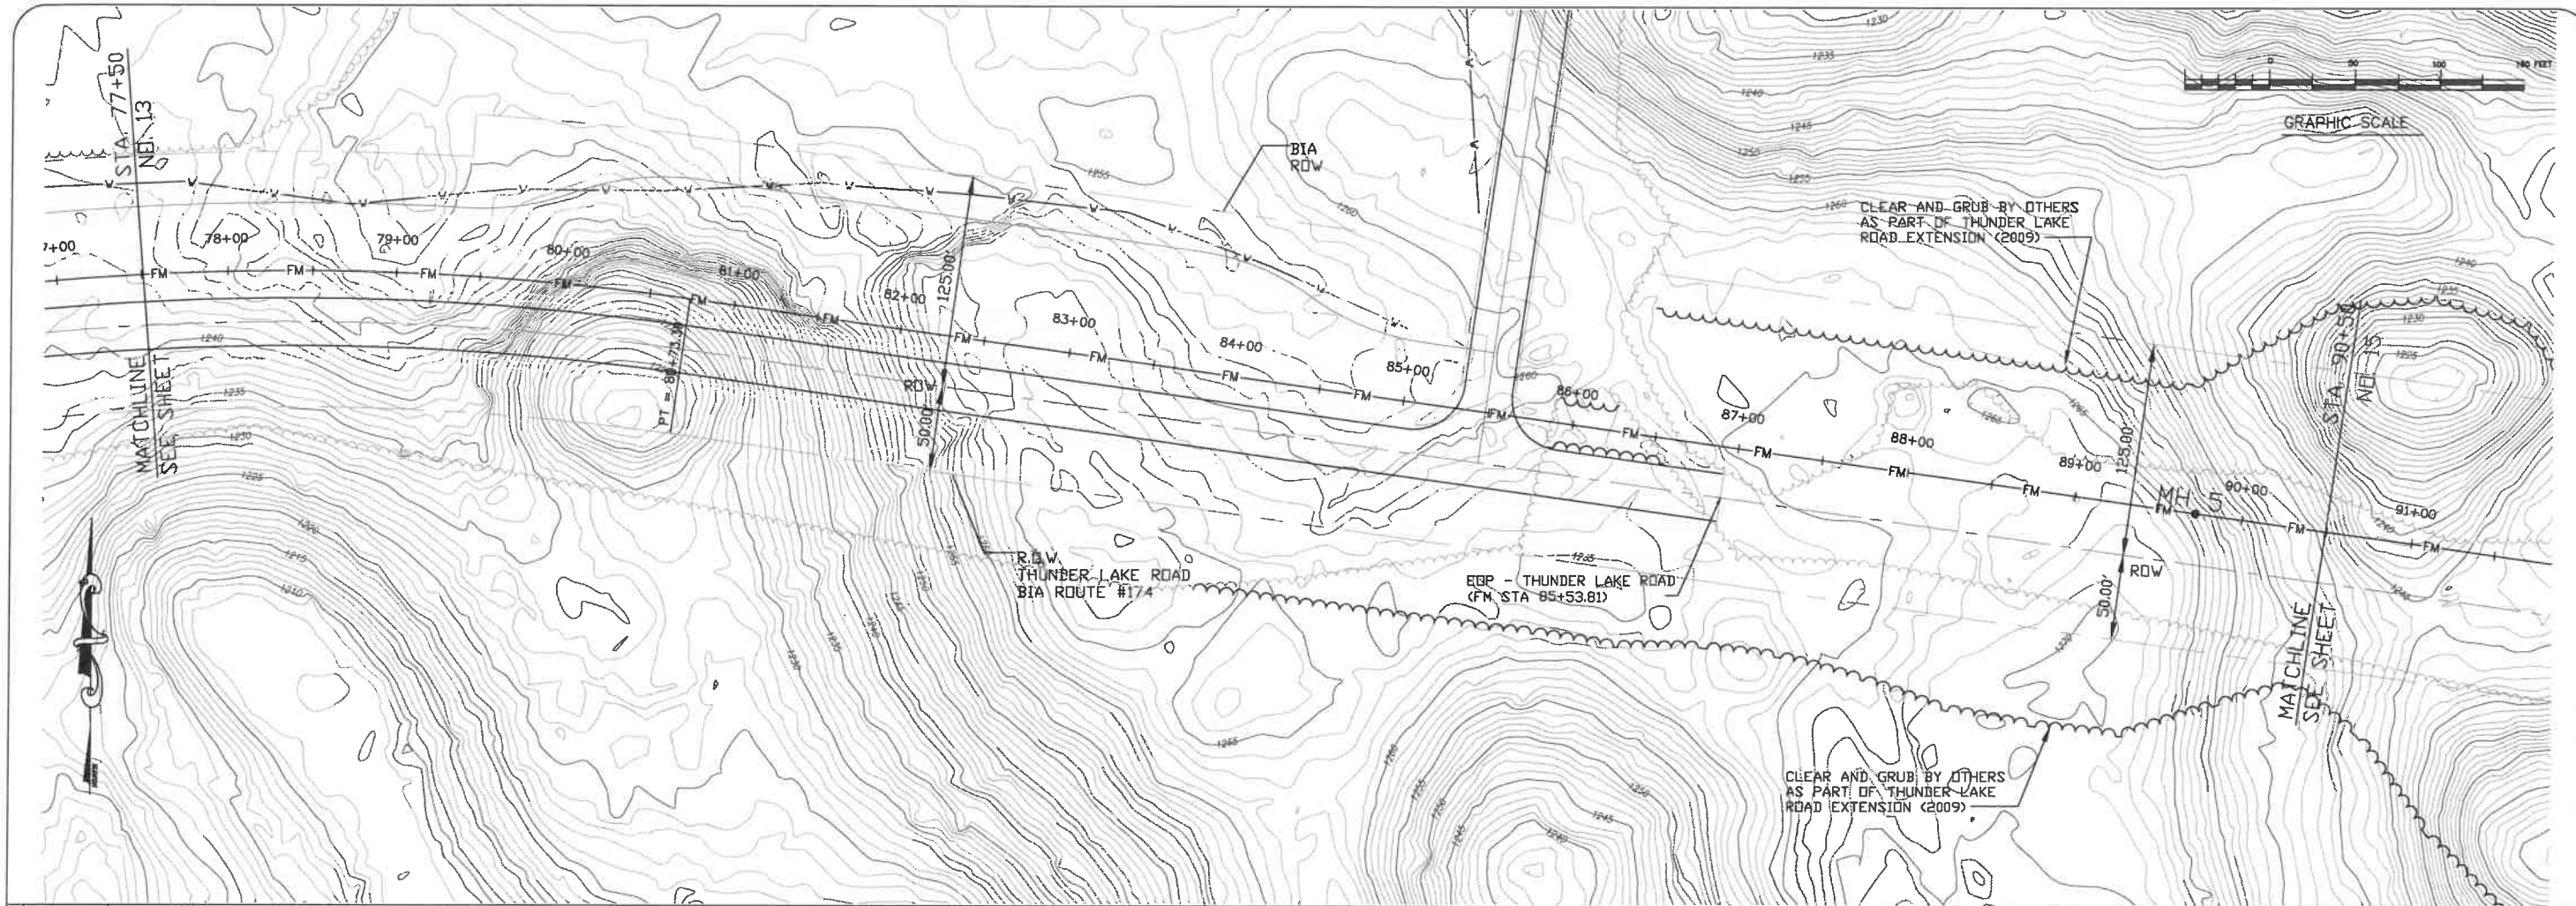

REVISIONS:	NO.	DATE	DESCRIPTION	BY
AS-BUILT				

I HEREBY CERTIFY THAT THIS PLAN, SPECIFICATION OR REPORT WAS PREPARED BY ME OR UNDER MY DIRECT SUPERVISION AND THAT I AM A DULY LICENSED PROFESSIONAL ENGINEER UNDER THE LAWS OF THE STATE OF MINNESOTA.

Michael C. McFarlane
MICHAEL C. MCFARLANE
REG. NO. 44196




RED LAKE WASTEWATER FACILITIES
PLAN AND PROFILE
RED LAKE RESERVATION, MINNESOTA

JOB NO. 03-42
DATE: 03-29-2011

SHEET NO.
14 OF 27

S:\NECI\Projects\03-42-rl waste water (bigoon)\03-42 AS-BUILT\DWG\03-42main.dwg, Sheet 15, 3/29/2011 10:37:30 AM, ssnopl

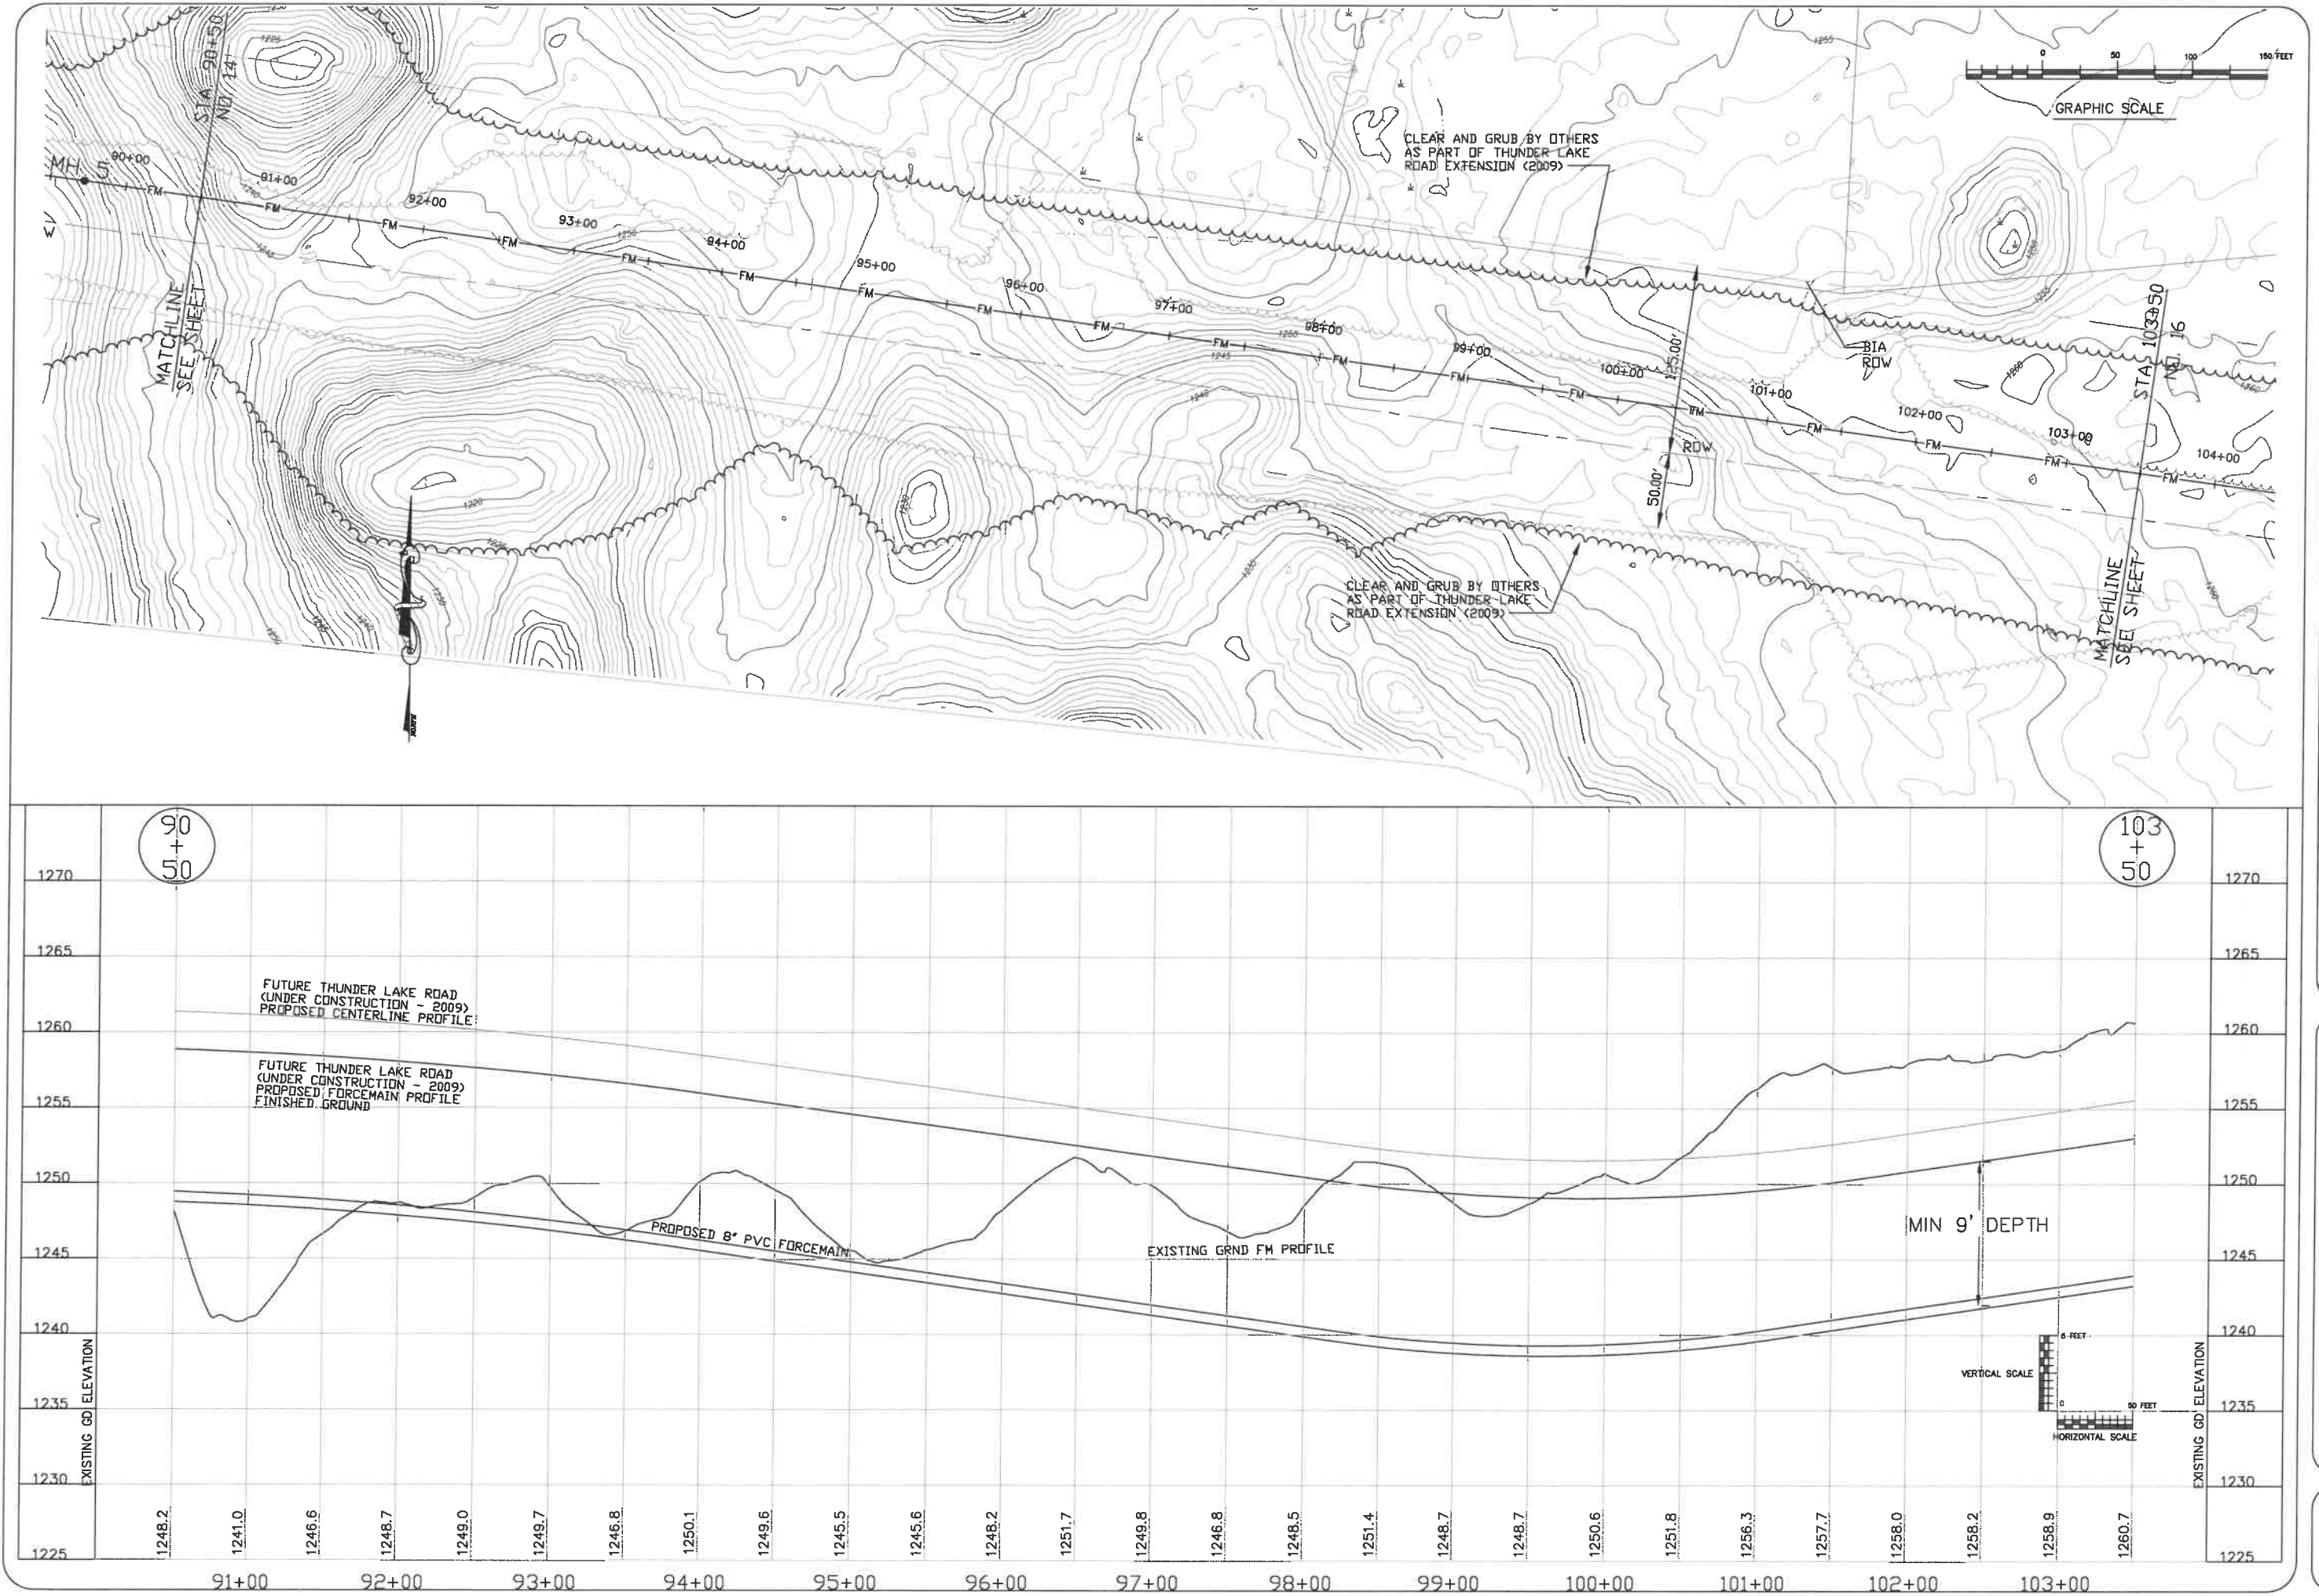

REVISIONS:			
NO.	DATE	DESCRIPTION	BY
1			
AS-BUILT			

I HEREBY CERTIFY THAT THIS PLAN, SPECIFICATION OR REPORT WAS PREPARED BY ME OR UNDER MY CLOSE PERSONAL SUPERVISION AND THAT I AM A DULY LICENSED PROFESSIONAL ENGINEER UNDER THE LAWS OF THE STATE OF MINNESOTA.

Michael C. McFarlane
MICHAEL C. MCFARLANE
REG. NO. 44186





RED LAKE WASTEWATER FACILITIES
PLAN AND PROFILE
RED LAKE RESERVATION, MINNESOTA

JOB NO. 03-42
DATE: 03-29-2011

SHEET NO.
15 OF 27

S:\NEC\Projects\03-42.r1 waste water (lagoon)\03-42 AS-BUILT.dwg 03-42main.dwg, Sheet 16, 3/29/2011 10:37:40 AM, ssnopl

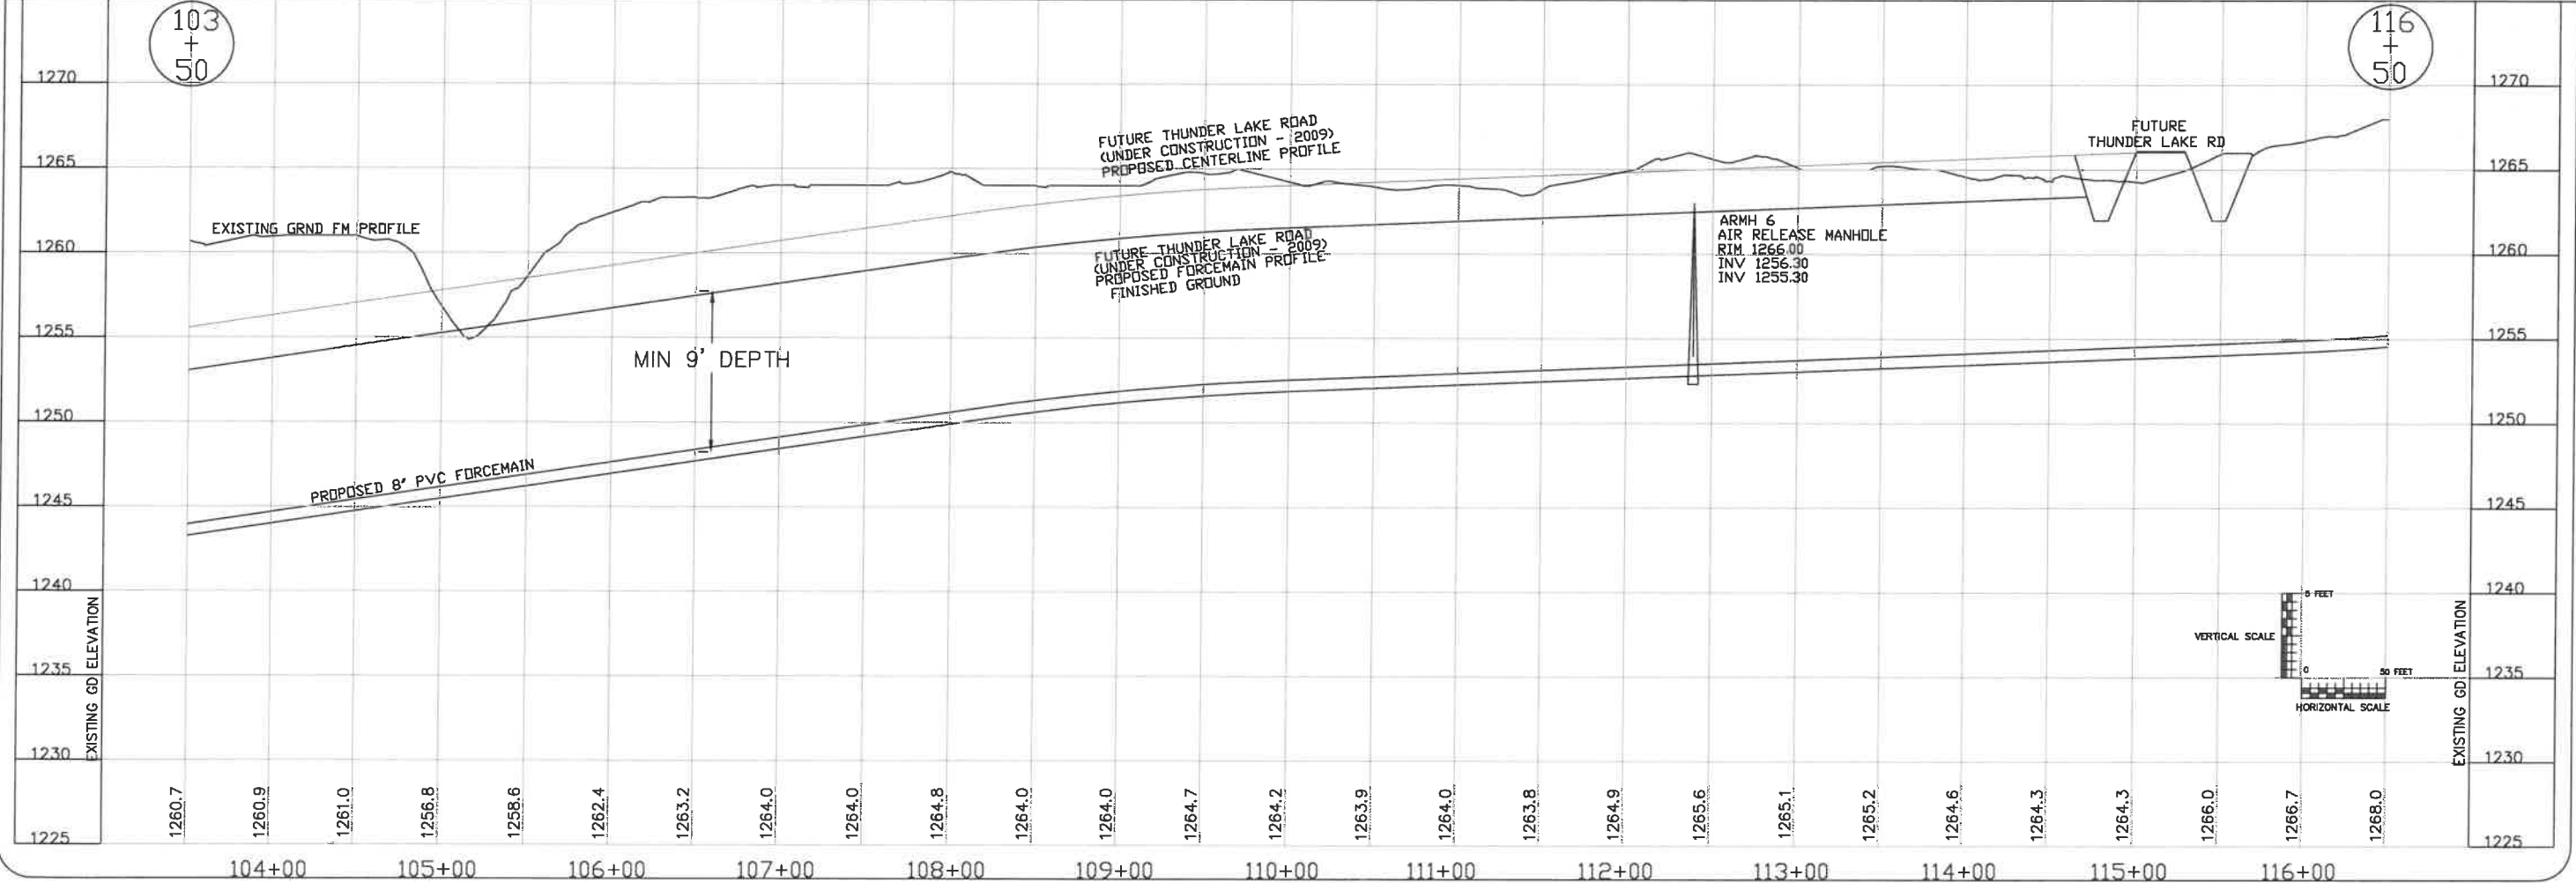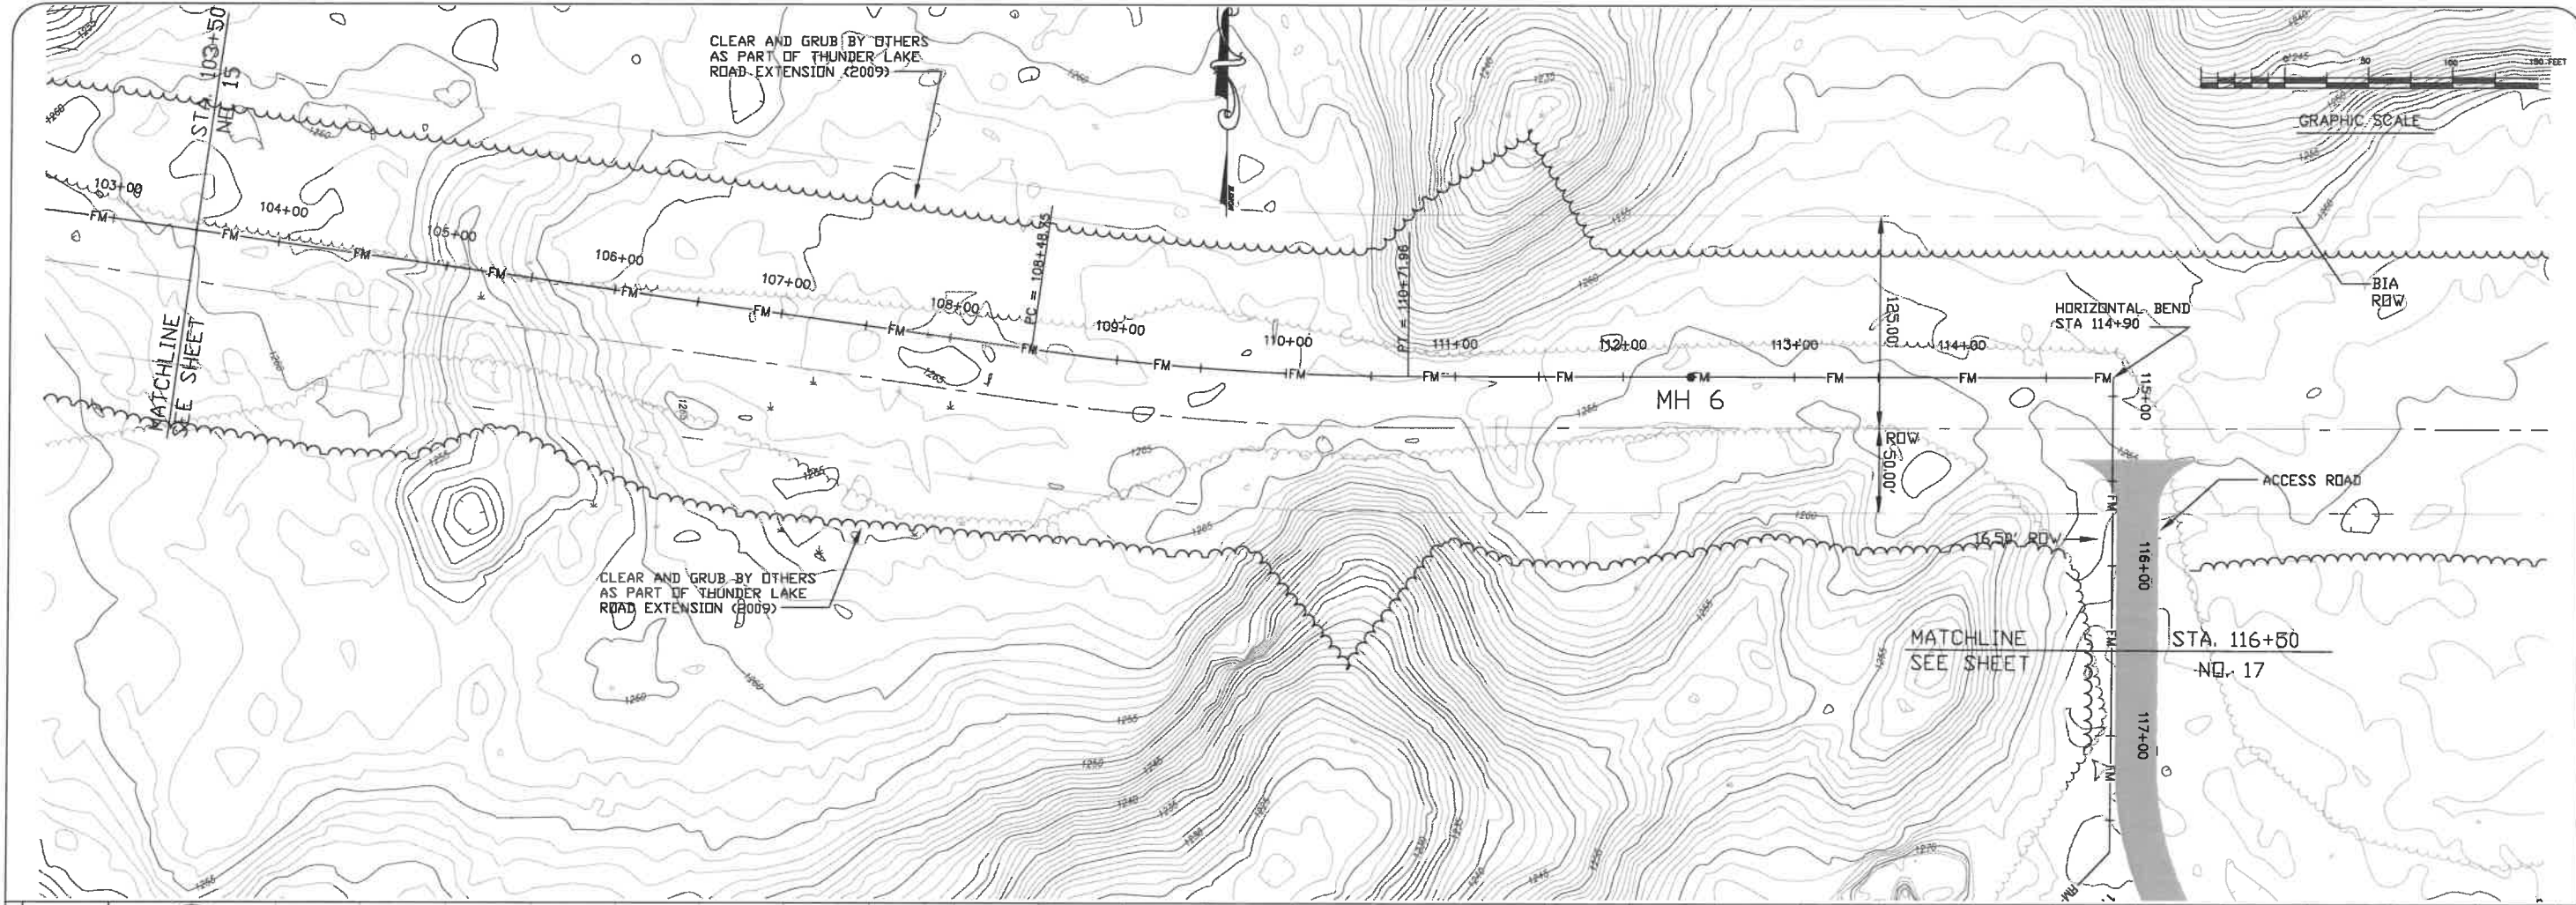

REVISIONS:		NO.	DATE	DESCRIPTION	BY
AS-BUILT					



I HEREBY CERTIFY THAT THIS PLAN, SPECIFICATION OR REPORT WAS PREPARED BY ME OR UNDER MY CLOSE PERSONAL SUPERVISION AND THAT I AM A DULY LICENSED PROFESSIONAL ENGINEER UNDER THE LAWS OF THE STATE OF MINNESOTA.

Michael C. McFarlane
MICHAEL C. MCFARLANE REG. NO. 44196

McFARLANE ENGINEERING & CONSULTING, INC.
207 4th Street NW, Bemidji, MN 56601
Phone: 218-444-4860, Fax: 218-444-6042
web: www.mcfarlane.com

RED LAKE WASTEWATER FACILITIES
PLAN AND PROFILE
RED LAKE RESERVATION, MINNESOTA

S:\NEC\Projects\03-42 r waste water (Bagoon)\03-42 AS-BUILT\DWG\03-42mar.dwg, Sheet 17, 3/29/2011 10:37:50 AM, ssnopl

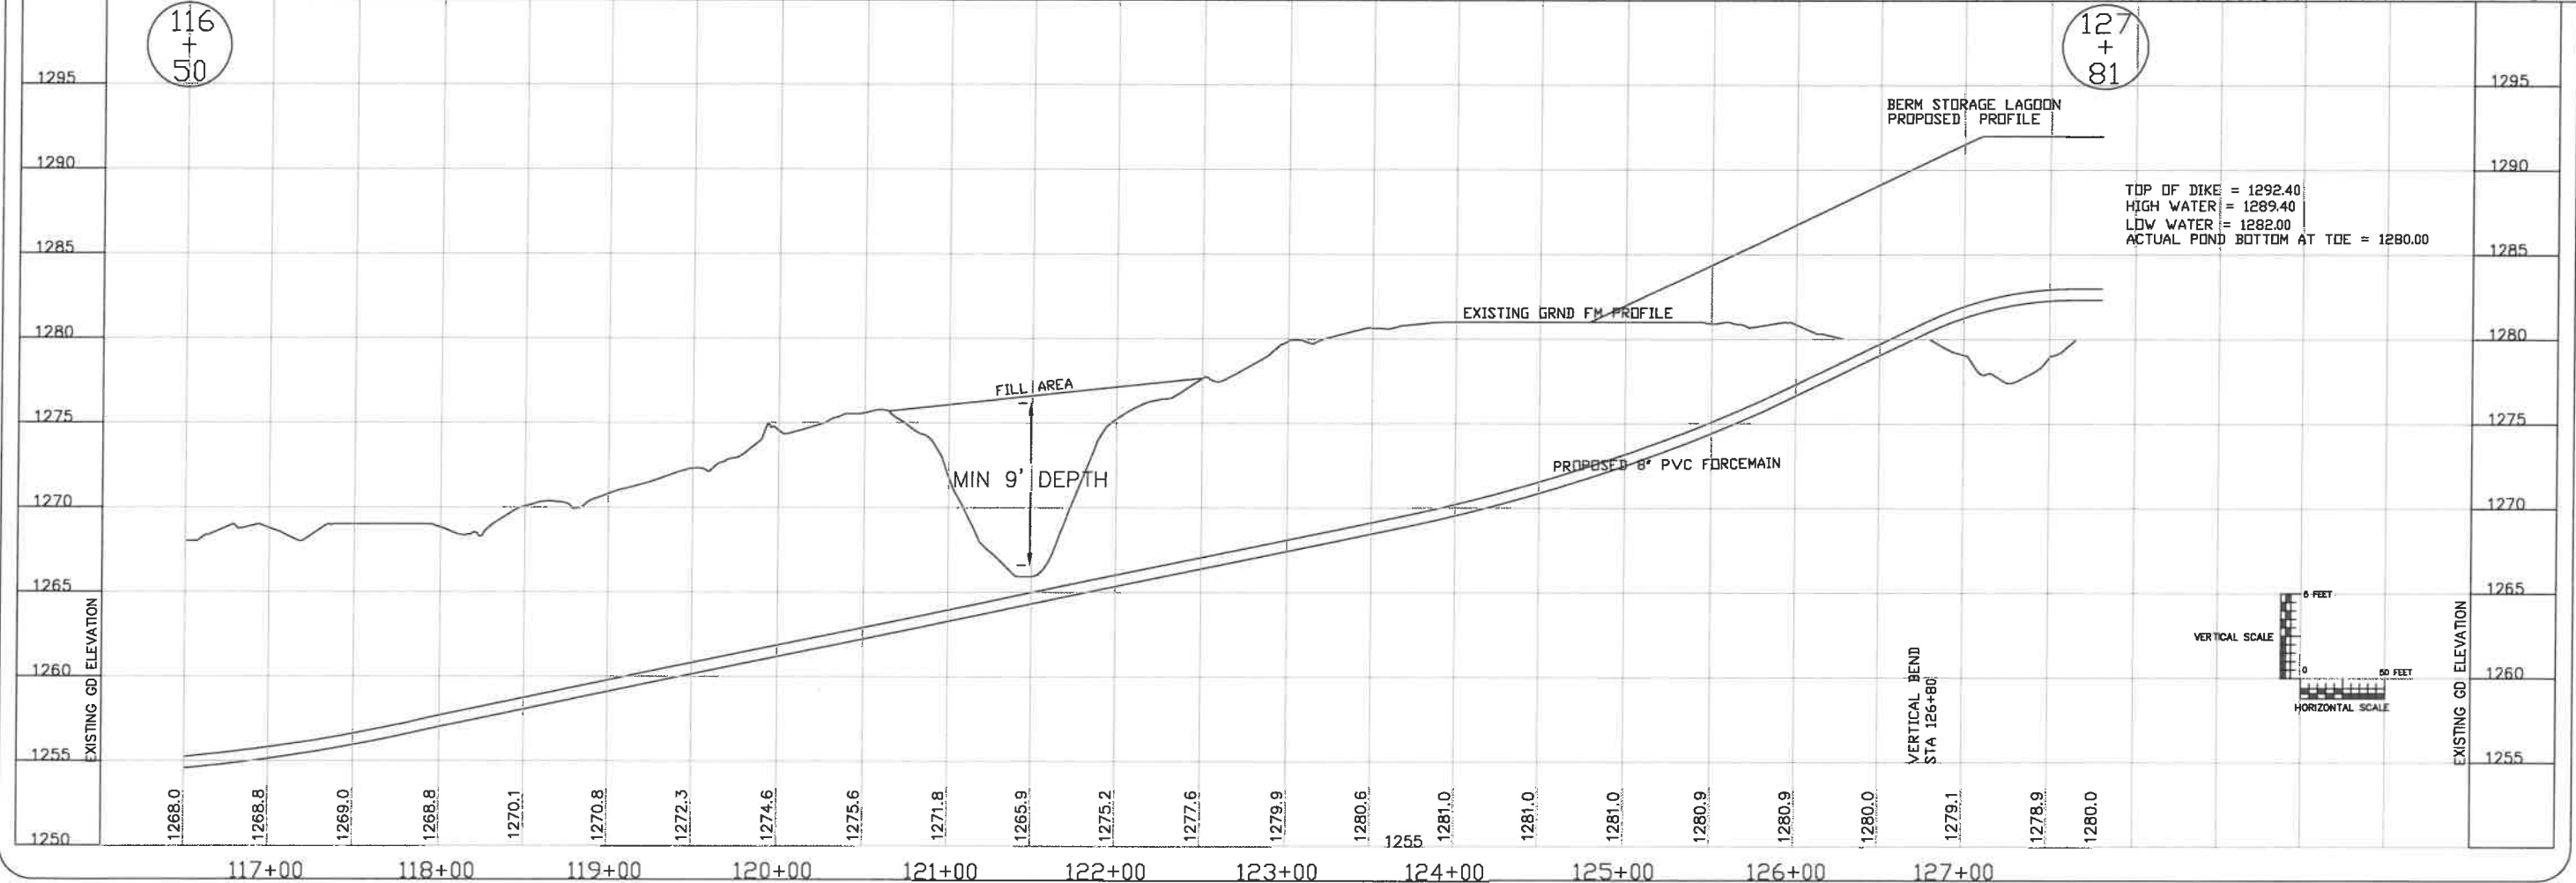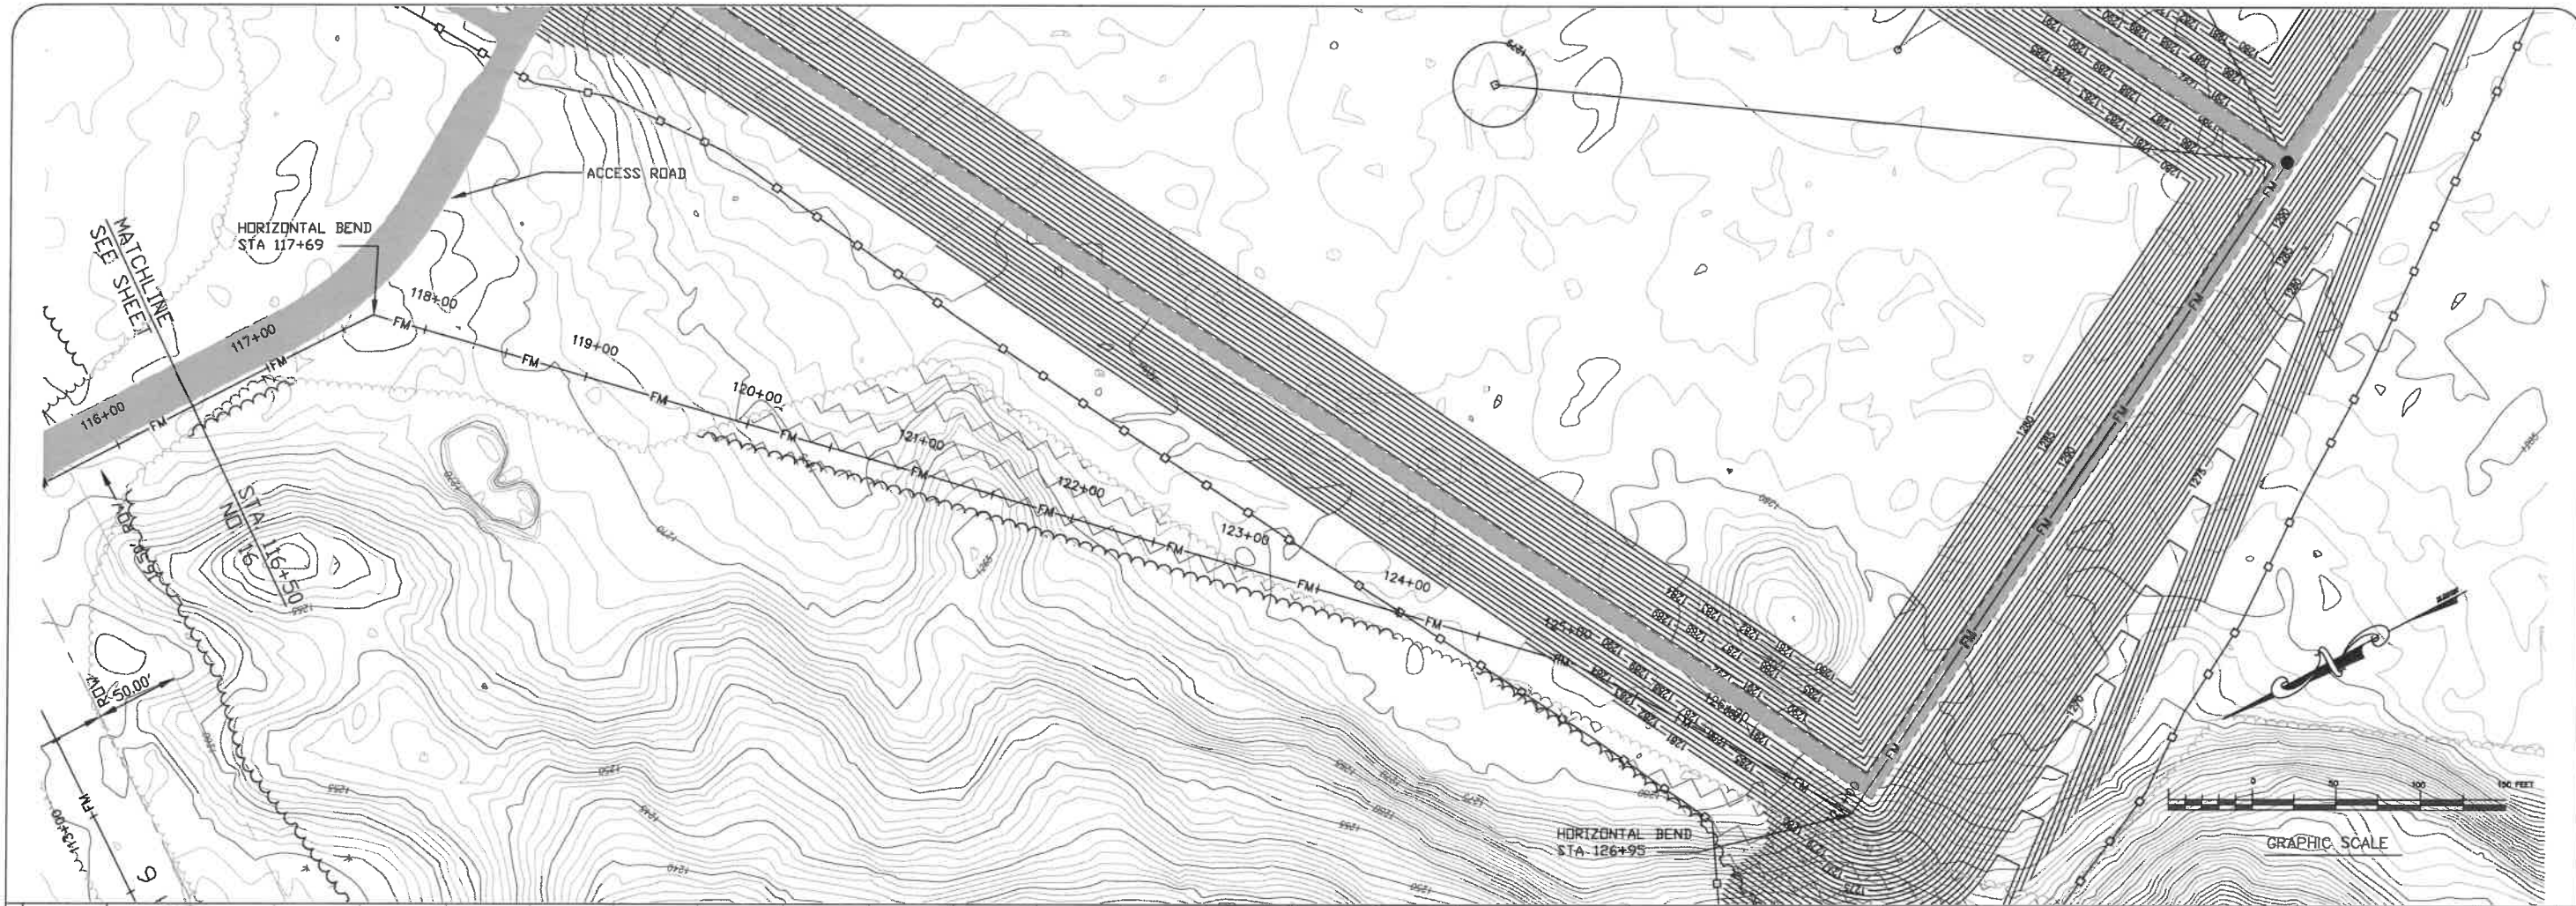

REVISIONS:

NO.	DATE	DESCRIPTION
1		AS-BUILT

I HEREBY CERTIFY THAT THIS PLAN, SPECIFICATION OR REPORT WAS PREPARED BY ME OR UNDER MY CLOSE PERSONAL SUPERVISION AND THAT I AM A LICENSED PROFESSIONAL ENGINEER UNDER THE LAWS OF THE STATE OF MINNESOTA.

Michael C. McFarlane
MICHAEL C. MCFARLANE
REG. NO. 44198

NORTHERN ENGINEERING & CONSULTING, INC.
207 4th Street NW, Bemidji, MN 56601
Phone: 218-444-4861, Fax: 218-444-6042
WEB: WWW.NECCS.COM

RED LAKE WASTEWATER FACILITIES

PLAN AND PROFILE


RED LAKE RESERVATION, MINNESOTA

JOB NO. 03-42
DATE: 03-29-2011

SHEET NO.
17 OF 27



S:\NEC\Projects\03-42 r1 waste water (lagoon)\03-42 AS-BUILT.dwg(03-42main.dwg, Sheet 18-Erosion Control 3/29/2011 10:38:56 AM, ssmpl)

NOT TO SCALE

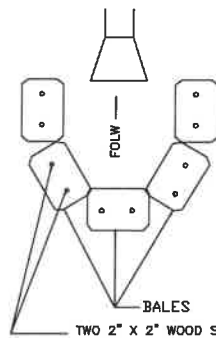

DIVERSIONS				
FORCEMAIN - LAGOON				
STATION	TYPE	LT	RT	
30+50	1	-	5	
41+05	1	-	5	
42+40	1	-	5	
66+95	1	5	-	
72+60	1	5	-	
		10	15	
		25		


① BALE DIVERSION AT INLET (CENTERLINE CULVERTS)
NTS

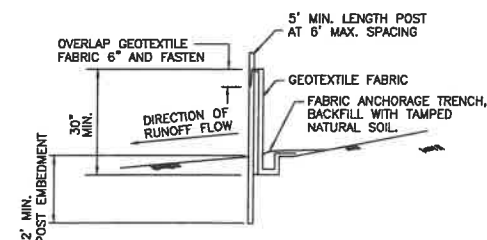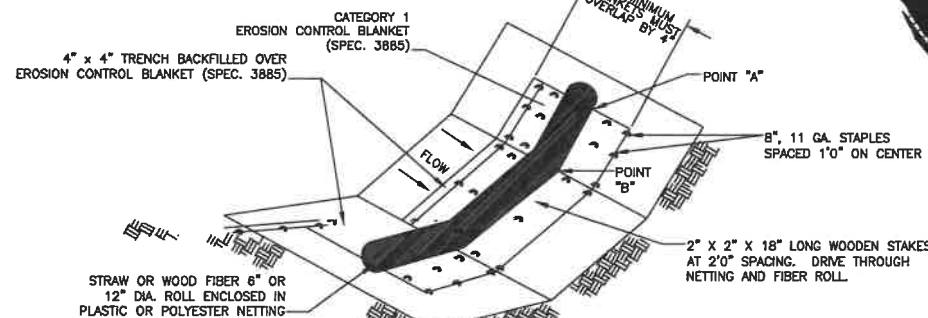

③ SILT FENCE DETAIL
NTS

SILT FENCE TO BE PAID FOR AT CONTRACT PRICE, AS SILT FENCE MACHINE SLICED (MNDOT 2573.502).

SILT FENCE		
FORCEMAIN - LAGOON		
STATION	LT	RT
40+42	-	50
54+50	300	-
66+00	400	-
95+50	300	-
LAGOON	6775	
	7825	

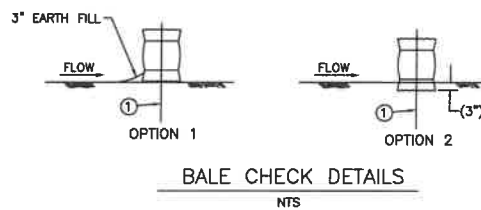

① TWO 2" X 2" WOOD STAKES OR REINFORCING BARS IN EACH BALE AND EMBEDDED IN THE GROUND 10" MINIMUM.

BIOROLLS		
FORCEMAIN - LAGOON		
STATION	LT	RT
50+25	10'	-
54+15	10'	-
58+15	10'	-
61+80	10'	-
64+80	10'	-
66+65	10'	-
72+25	10'	-
75+85	10'	-
77+90	10'	-
82+45	10'	-
84+95	10'	-
86+95	10'	-
	120'	

POINT "A" MUST BE HIGHER THEN POINT "B" TO ENSURE THAT WATER FLOWS OVER THE DIKE AND NOT AROUND THE ENDS.

② BIOROLL BLANKET SYSTEM
(TYPE 3 SPEC. 3889)

RECOMMENDED SPACING BETWEEN DITCH CHECKS	
DITCH GRADE (%)	SPACING (FT.)
2-4	100
4-6	75
6-8	50
8-10	40
>10	25

RED LAKE WASTEWATER FACILITIES
EROSION CONTROL SHEET
RED LAKE RESERVATION, MINNESOTA

JOB NO. 03-42
DATE: 03-29-2011

SHEET NO.
18 OF 27

I HEREBY CERTIFY THAT THIS PLAN, SPECIFICATION AND CALCULATIONS WERE PREPARED BY ME OR UNDER MY DIRECT SUPERVISION AND THAT I AM A LICENSED PROFESSIONAL ENGINEER UNDER THE LAWS OF THE STATE OF MINNESOTA.


Michael C. McFarlane
MICHAEL C. MCFARLANE
REG. NO. 44186

NORTHERN ENGINEERING & CONSULTING, INC.
207 4th Street NW, Bemidji, MN 56601
Phone: 218-444-4860 Fax: 218-444-6042
Web: www.necusa.com

REVISIONS:

NO.	DATE	DESCRIPTION	BY
AS-BUILT			


S:\NED\Projects\03-42 1 waste water (lagoon)\03-42 AS-BUILT.dwg (03-42main.dwg, Sheet 19-SWPPP, 3/29/2011 10:40:29 AM, sscopl

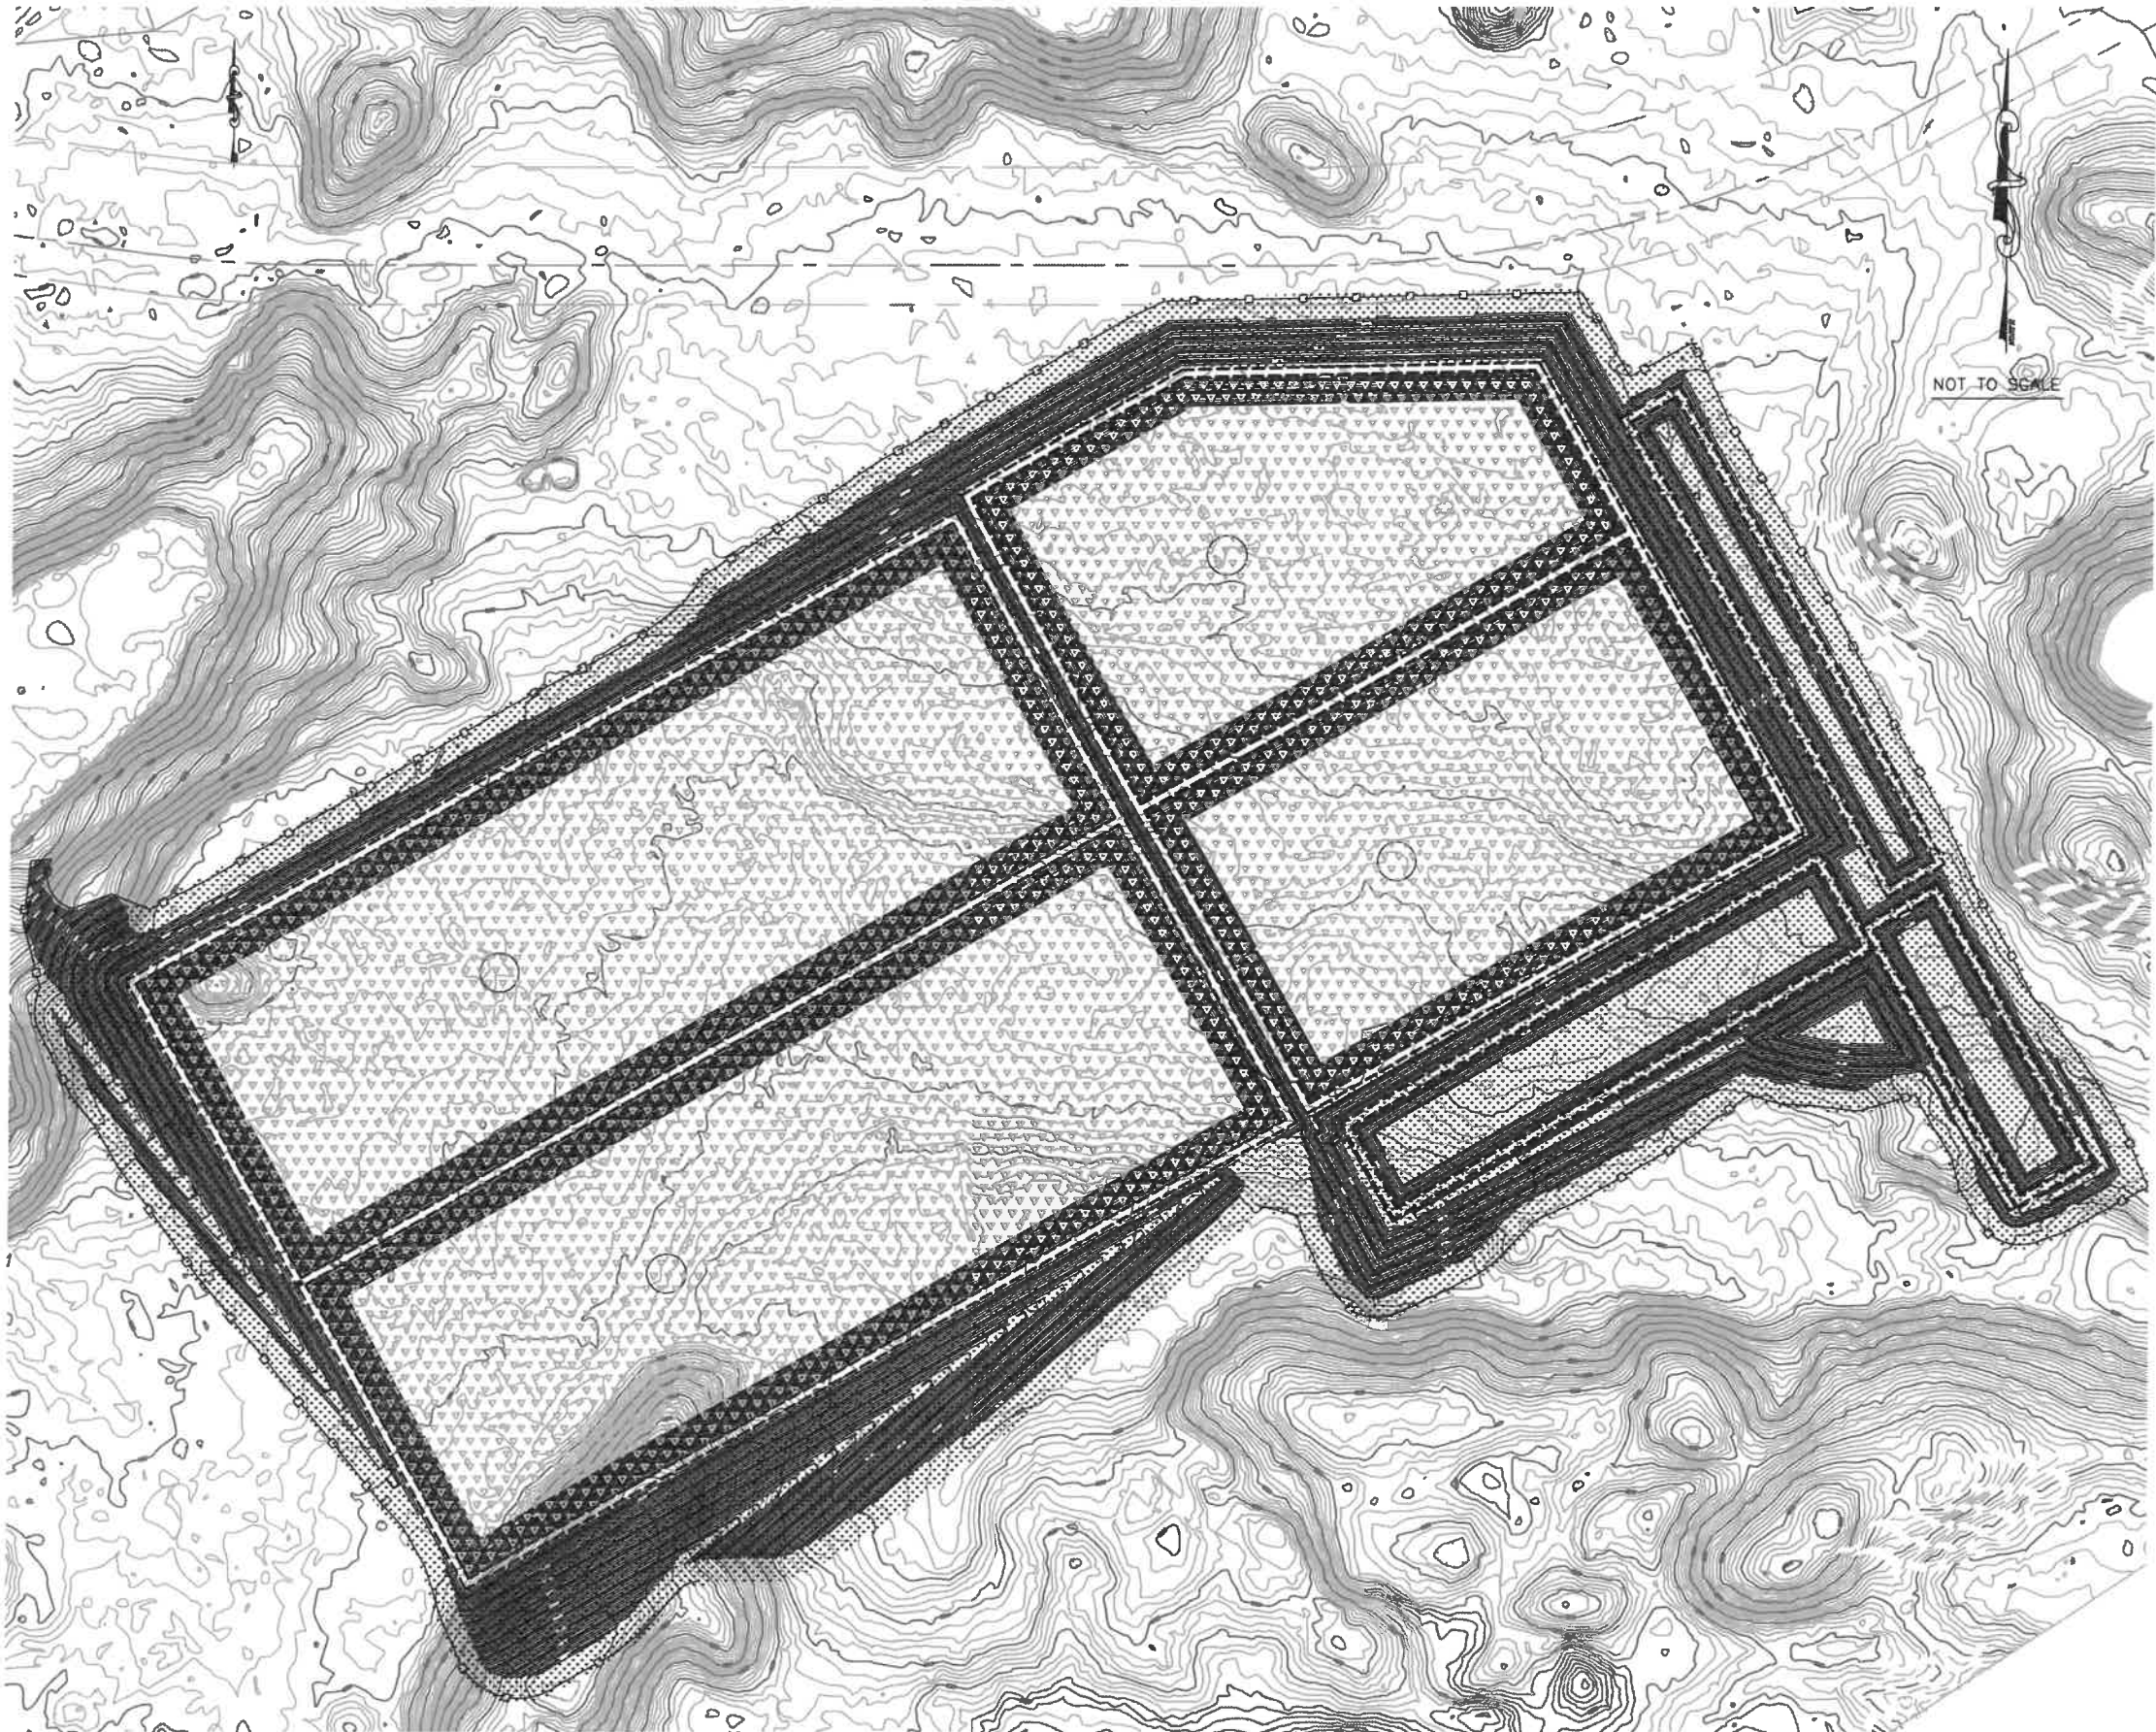


LEGEND



GEOMEMBRANE LINER
(SEE DETAILS AND SPECIFICATIONS)

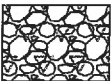

RIP RAP / GEOMEMBRANE LINER
(SEE DETAILS AND SPECIFICATIONS)

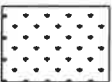

SEEDED GRASS



PERIMETER SILT FENCE

EROSION AND SEDIMENT
CONTROL PLAN

- 1.) The Contractor shall obtain all permits prior to start of construction.
- 2.) All exposed soil areas must have temporary erosion protection or permanent cover according to the following:

Type of Slope	Time (Maximum time an area can remain open when the area is not actively being worked.)
Slopes steeper than 3:1	within 7 days
Slopes between 10:1 and 3:1	within 14 days
Slopes flatter than 10:1	within 21 days

These areas include constructed storm water management pond side slopes, and any exposed soil areas with a positive slope to a storm water conveyance system, such as a curb and gutter system, storm sewer inlet, temporary or permanent drainage ditch or other natural or man made systems that discharge to a surface water.

- 3.) Pipe outlets must be provided with energy dissipation with 24 hours of connection to surface water.
- 4.) All storm sewers discharging into wetlands or water bodies shall outlet at or below the normal water level of the respective wetland or water body or at an elevation where the downstream slope is 1 percent or flatter. The normal water level shall be the invert elevation of the outlet of the wetland or water body.
- 5.) All grading operations shall be conducted in a manner to minimize the potential for site erosion. Sediment control practices must be established on all down gradient perimeters before any up gradient land disturbing activities begin.
- 6.) In areas where concentrated flows occur (such as swales and areas in front of storm catch basins and intakes) the erosion control facilities shall be backed by a stabilization structure to protect those facilities from the concentrated flows.
- 7.) All storm sewer catch basins not needed for site drainage during construction shall be covered to prevent runoff from entering the storm sewer system. Catch basins necessary for site drainage during construction shall be surrounded by silt fence or double ring of stacked hay bales backed by snow fences. The fence or bales shall be installed and maintained around all catch basins until the tributary areas are restored.
- 8.) All construction site entrances shall be surfaced with crushed rock across the entire width of the entrance and from the entrance to a point 50 feet into the construction zone.
- 9.) The toe of the silt fence shall be trenched in a minimum of 6 inches. The trench backfill shall be compacted with a vibratory plate compactor.
- 10.) All riprap shall be designed and installed with a filter material and meet the Minnesota Department of Transportation specifications for riprap and filter material.
- 11.) Inspect the construction site once every seven (7) days during active construction and within 24 hours after a rainfall event greater than 0.5 inches in 24 hours.
- 12.) All silt fences must be repaired, replaced, or supplemented when they become nonfunctional or the sediment reaches 1/3 of the height of the fence. These repairs must be made within 24 hours of discovery, or as soon as field conditions allow access.
- 13.) If sediment escapes the construction site, off-site accumulations of sediment must be removed in a manner and at a frequency sufficient to minimize off-site impacts.
- 14.) All soils tracked onto pavement shall be removed daily.
- 15.) All permanent sedimentation basins must be restored to their design condition immediately following stabilization of the site.
- 16.) Upon completion of the project and stabilization of all graded areas, all temporary erosion control facilities (silt fences, hay bales, etc.) shall be removed from the site.

RED LAKE WASTEWATER FACILITIES

SITE EROSION CONTROL SHEET

RED LAKE RESERVATION, MINNESOTA

JOB NO. 03-42
DATE: 03-29-2011

SHEET NO.
19 OF 27


I HEREBY CERTIFY THAT THIS PLAN, SPECIFICATION OR REPORT WAS PREPARED BY ME OR UNDER MY CLOSE PERSONAL SUPERVISION AND THAT I AM A LICENSED PROFESSIONAL ENGINEER UNDER THE LAWS OF THE STATE OF MINNESOTA.

Michael C. McFarlane
MICHAEL C. MCFARLANE REG. NO. 44196

McFARLANE ENGINEERING & CONSULTING, INC.
207 4th Street NW, Bemidji, MN 56601
Phone: 218-444-4860, Fax: 218-444-6042
Web: www.mcfarlane.com

REVISIONS:	NO.	DATE	DESCRIPTION	BY
AS-BUILT				

S:\NEC\Projects\03-42 rl waste water (bigoon)\03-42 AS-BUILTS.dwg\03-42main.dwg, Sheet 20-Fencing, 3/29/2011 10:42:00 AM, ssnopl

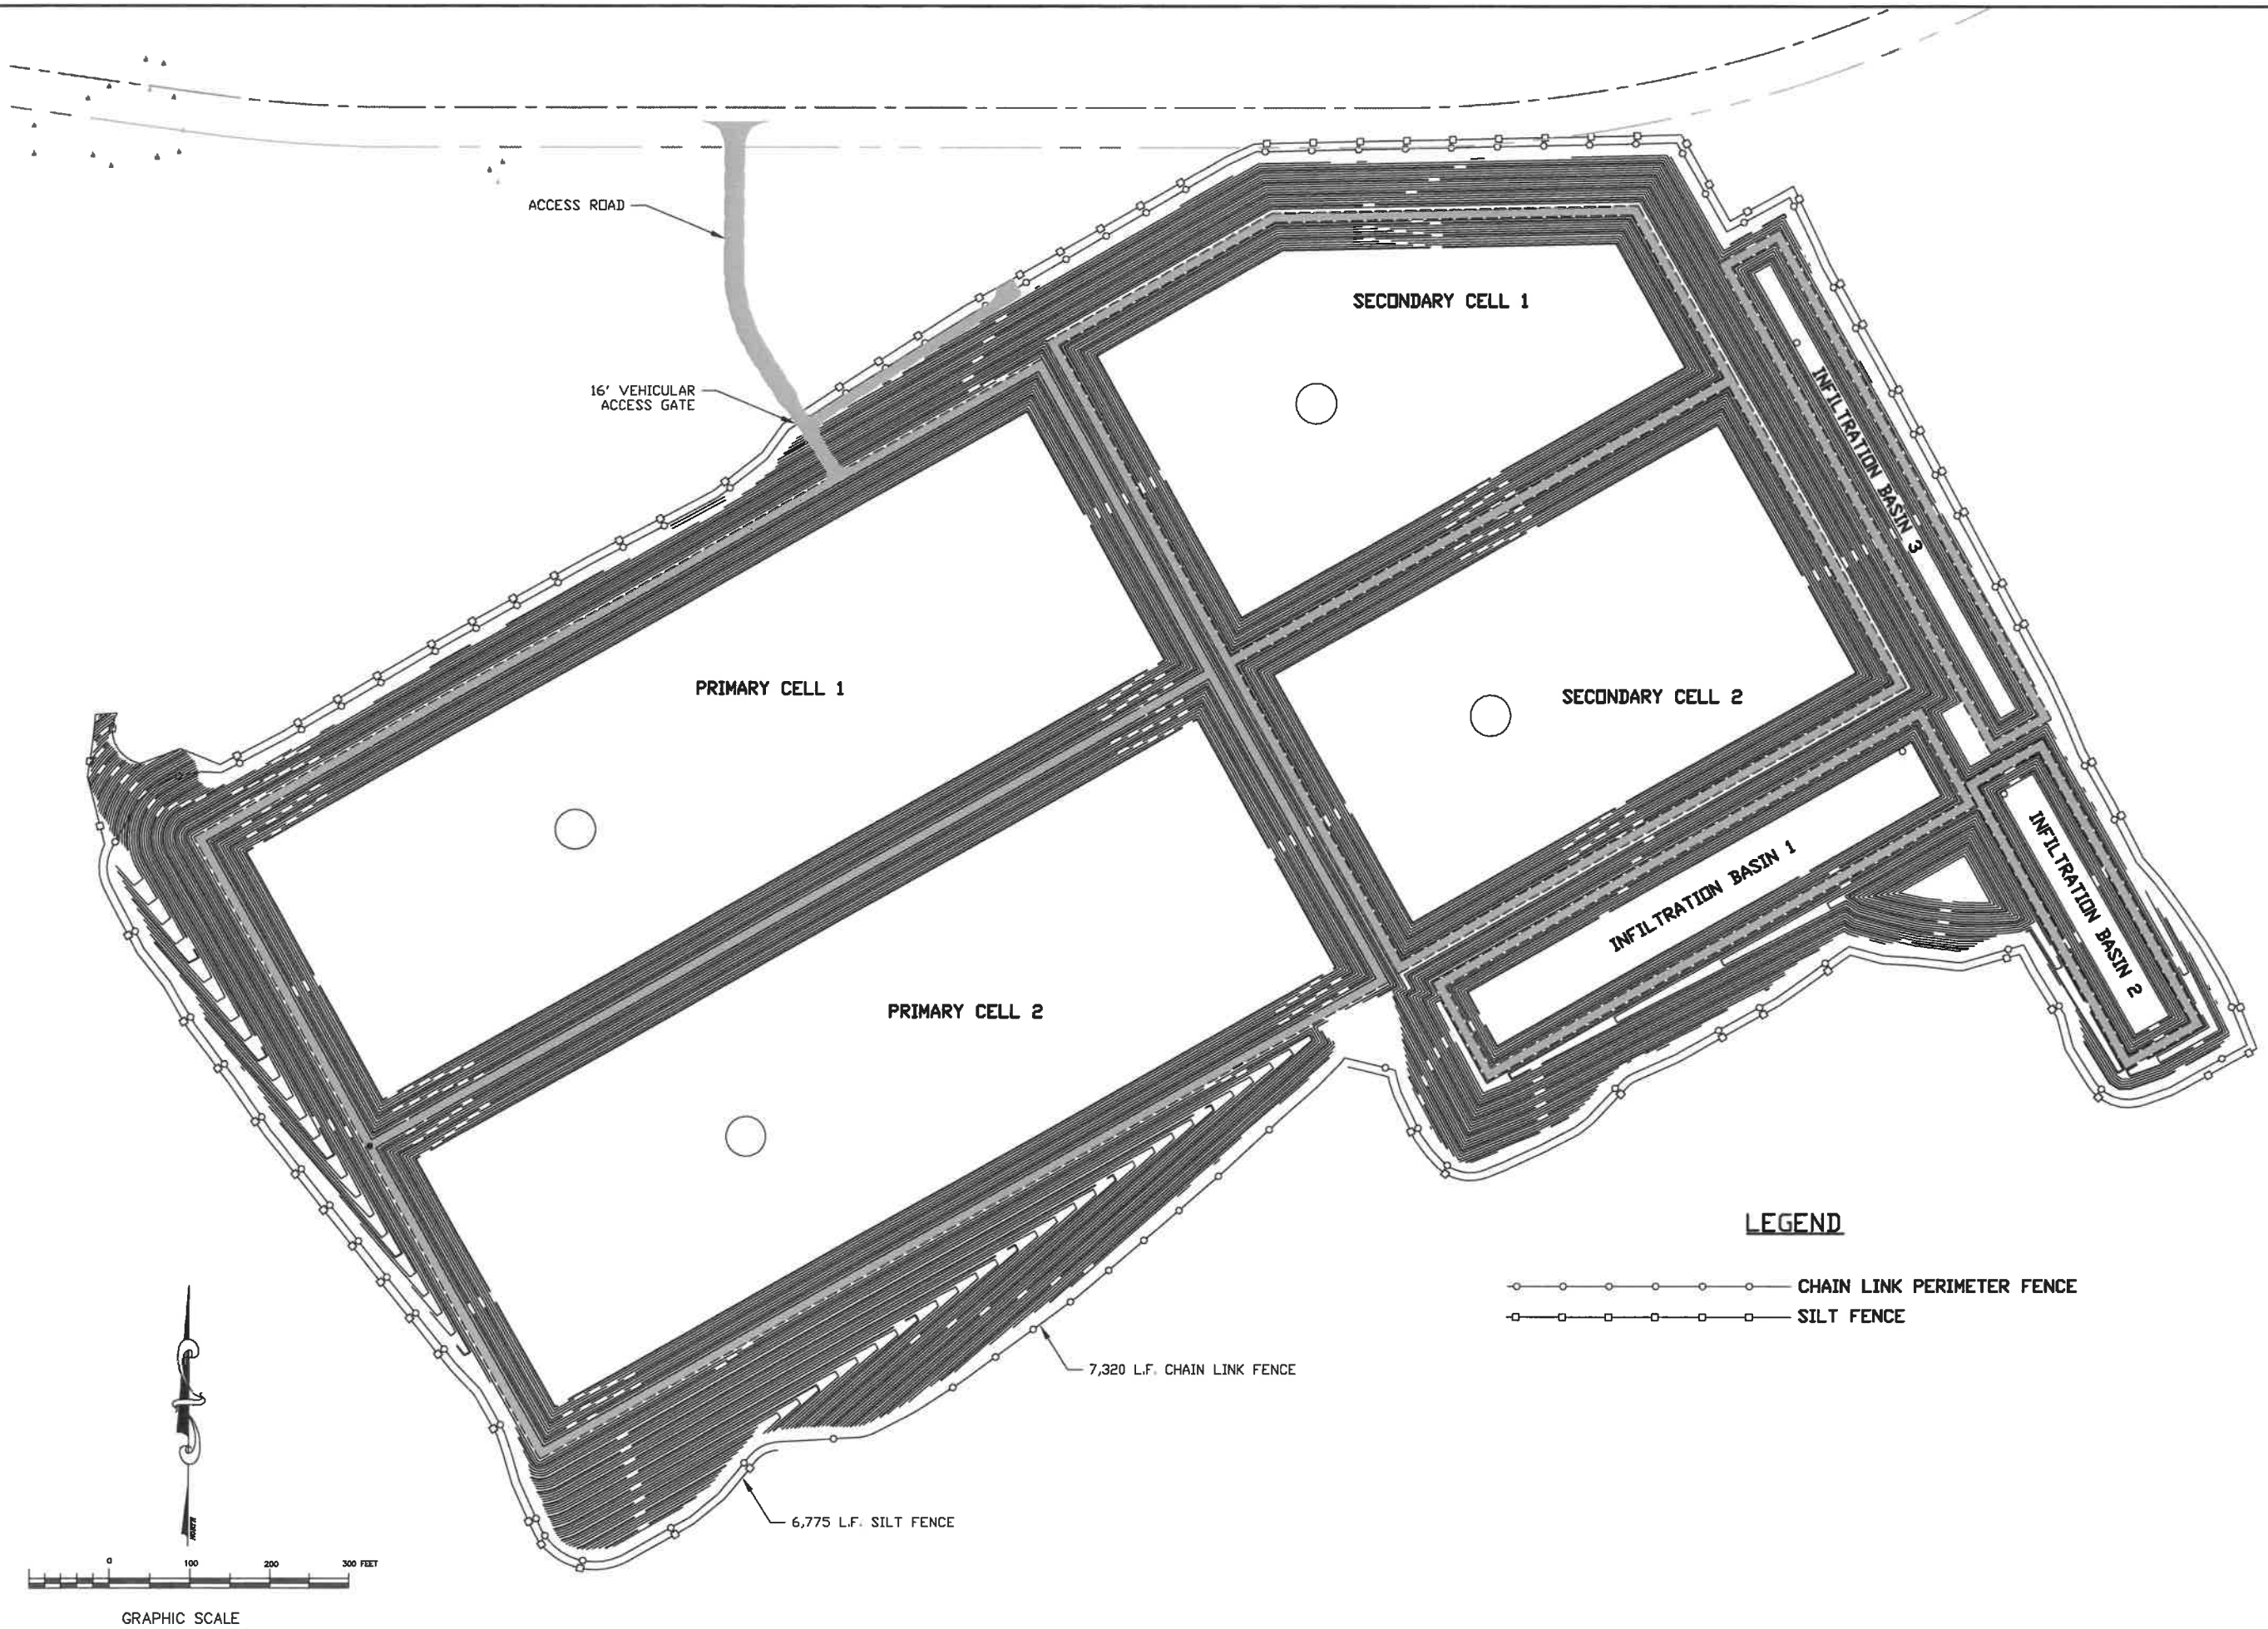

REVISIONS:			
NO.	DATE	DESCRIPTION	BY
AS-BUILT			

I HEREBY CERTIFY THAT THIS PLAN, SPECIFICATION OR REPORT WAS PREPARED BY ME OR UNDER MY CLOSE PERSONAL SUPERVISION AND THAT I AM A REGISTERED ENGINEER UNDER THE LAWS OF THE STATE OF MINNESOTA.

Michael C. McFarlane

MICHAEL C. MCFARLANE REG. NO. 44198


NORTHERN ENGINEERING & CONSULTING, INC.
207 4th Street NW, Bemidji, MN, 56601
Phone: 218-444-4860, Fax: 218-444-6042
web: www.nec-usa.com

RED LAKE WASTEWATER FACILITIES
FENCING LAYOUT
RED LAKE RESERVATION, MINNESOTA

JOB NO. 03-42
DATE: 03-29-2011

SHEET NO.
20 OF 27

S:\NEC\Projects\03-42 rl waste water (ligoon)\03-42 AS-BUILT\TS\dwg\03-42main.dwg, Sheet 21-Clar and Grub, 3/29/2011 10:43:42 AM, ssnopl

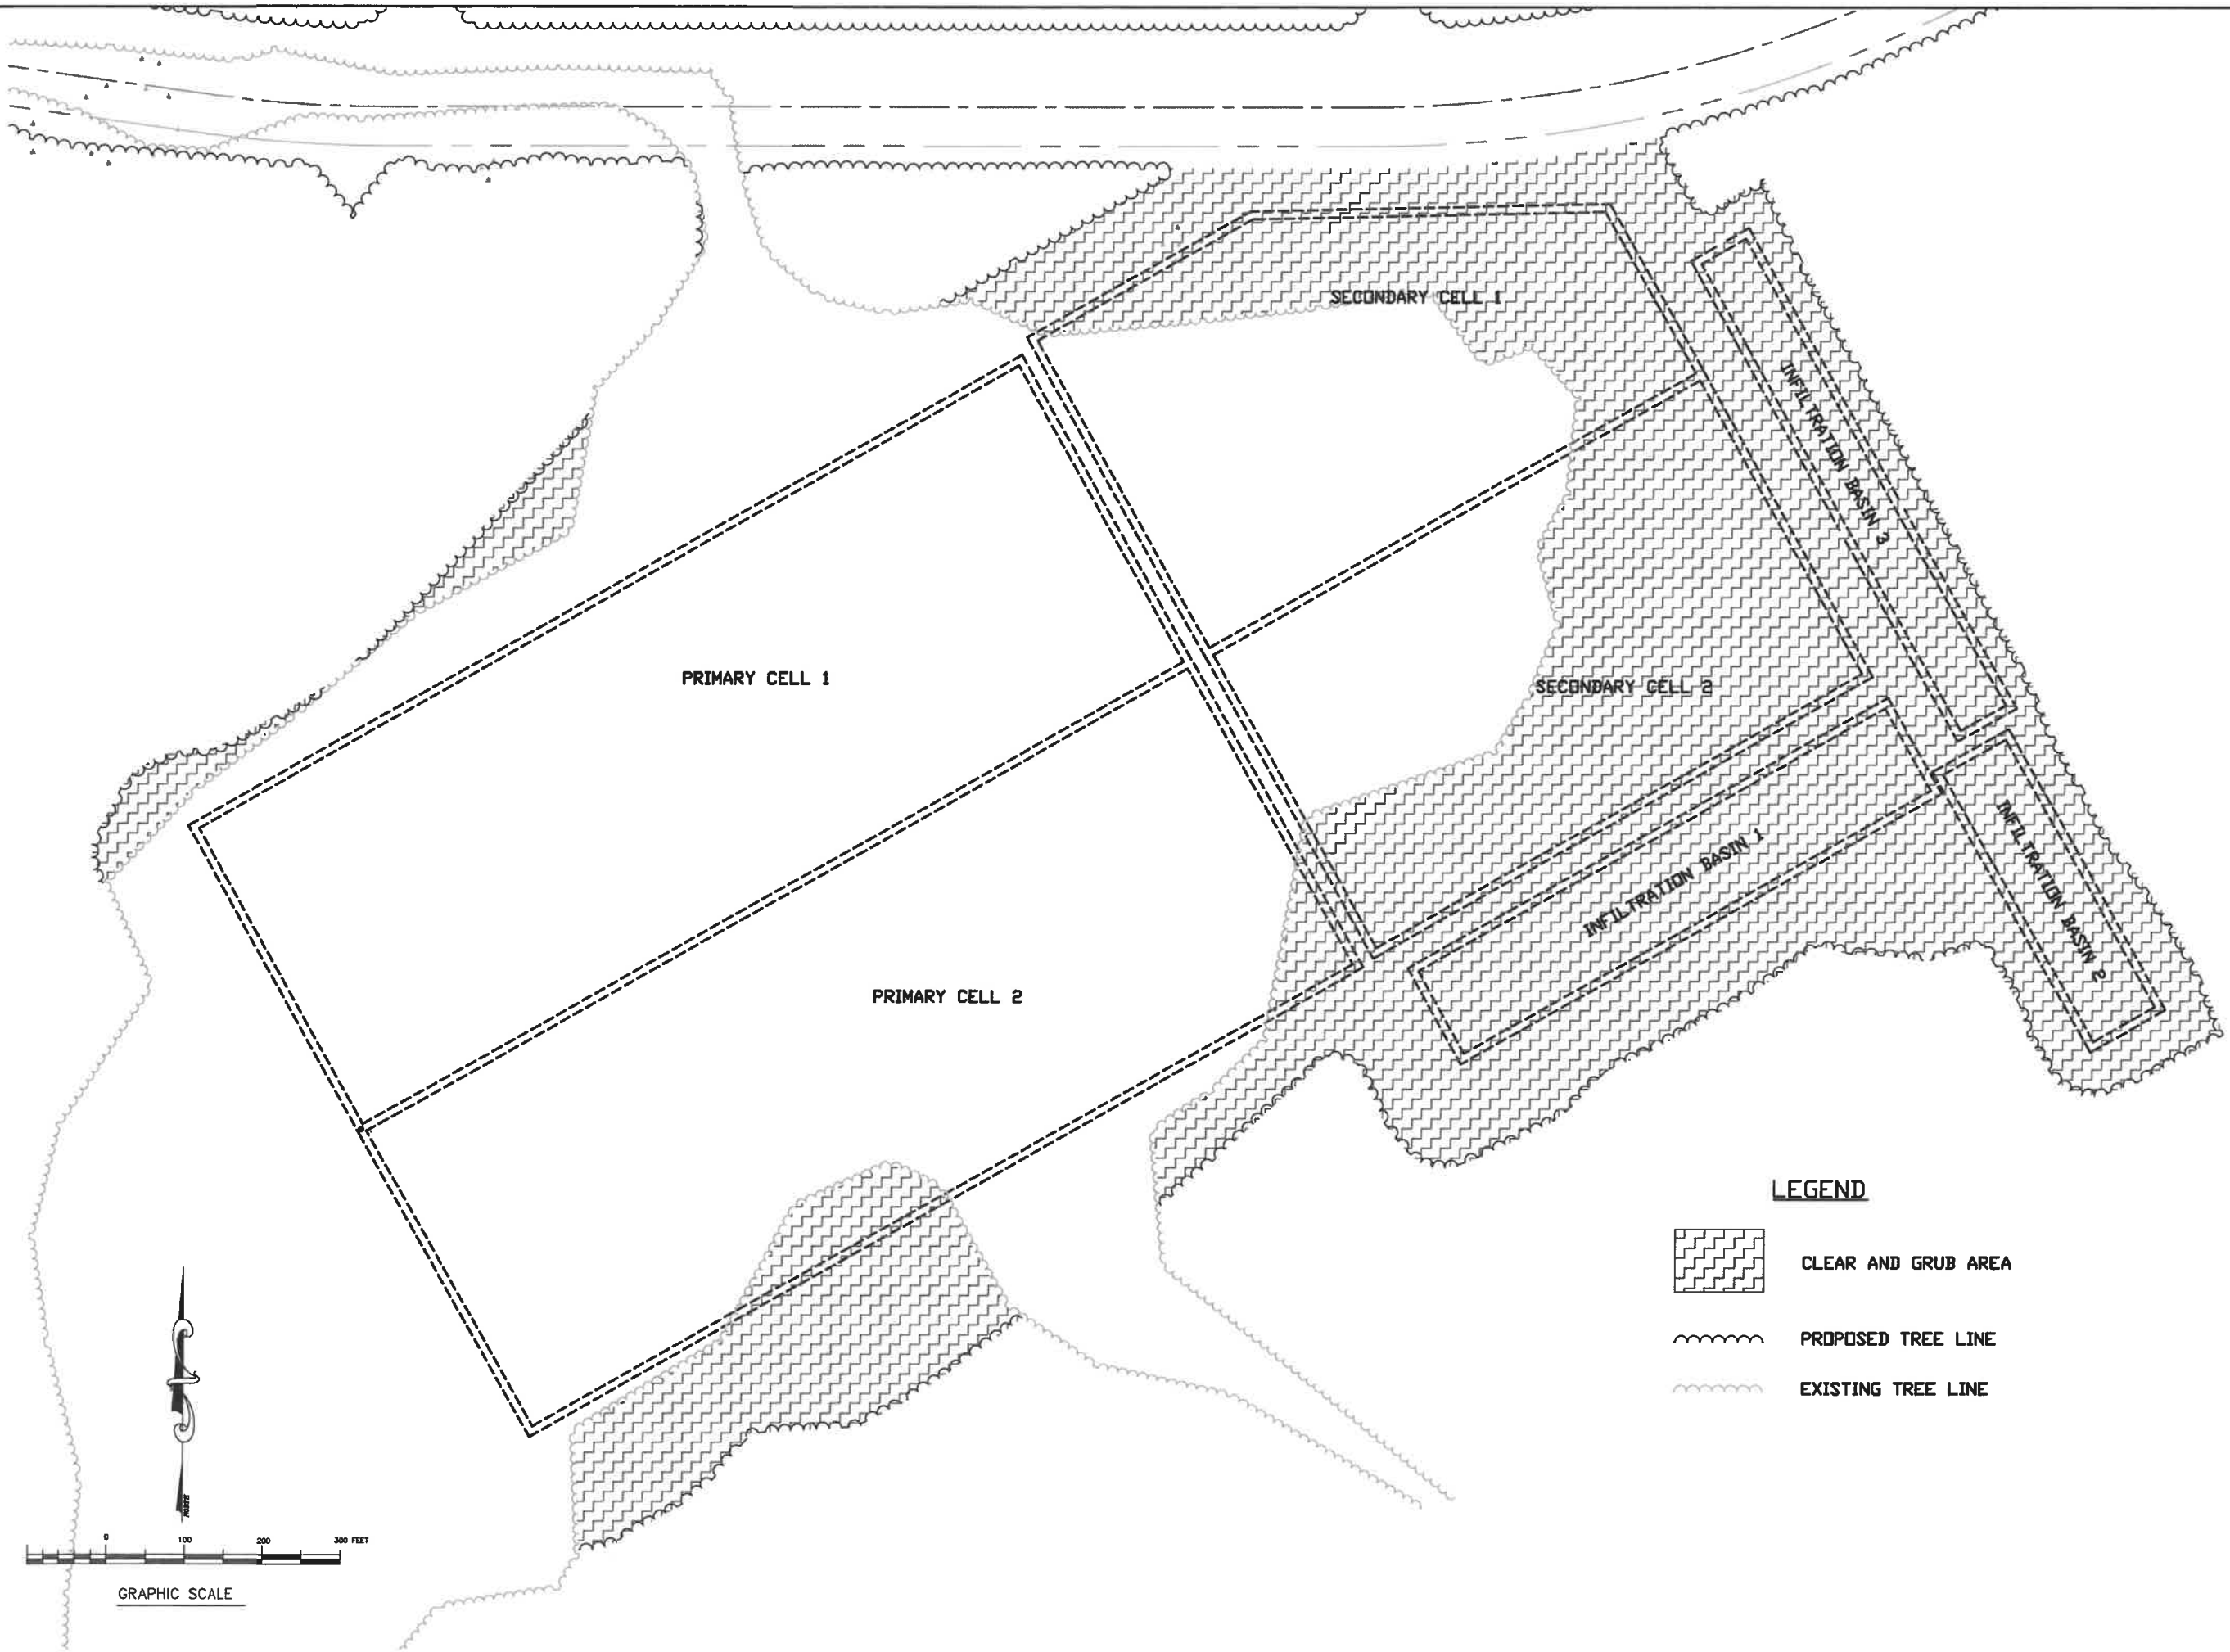

RED LAKE WASTEWATER FACILITIES
CLEARING AND GRUBBING PLAN
RED LAKE RESERVATION, MINNESOTA

JOB NO. 03-42
DATE: 03-29-2011


SHEET NO.
21 OF 27

NORTHERN ENGINEERING & CONSULTING, INC.
207 4th Street NW, Bemidji, MN, 56601
Phone: 218-444-4860, Fax: 218-444-6042
web: www.necusa.com

I HEREBY CERTIFY THAT THIS PLAN, SPECIFICATION OR REPORT WAS PREPARED BY ME OR UNDER MY CLOSE PERSONAL SUPERVISION AND THAT I AM A DULY LICENSED PROFESSIONAL ENGINEER UNDER THE LAWS OF THE STATE OF MINNESOTA.
Michael C. McFarlane
MICHAEL C. MCFARLANE REG. NO. 44196

REVISIONS:		
NO.	DATE	DESCRIPTION
AS-BUILT		

S:\NEC\Projects\03-42 rl waste water (bgoon)\03-42 AS-BUILTS.dwg\03-42main.dwg, Sheet 22-Grading 1, 3/29/2011 10:44:23 AM, ssnopl

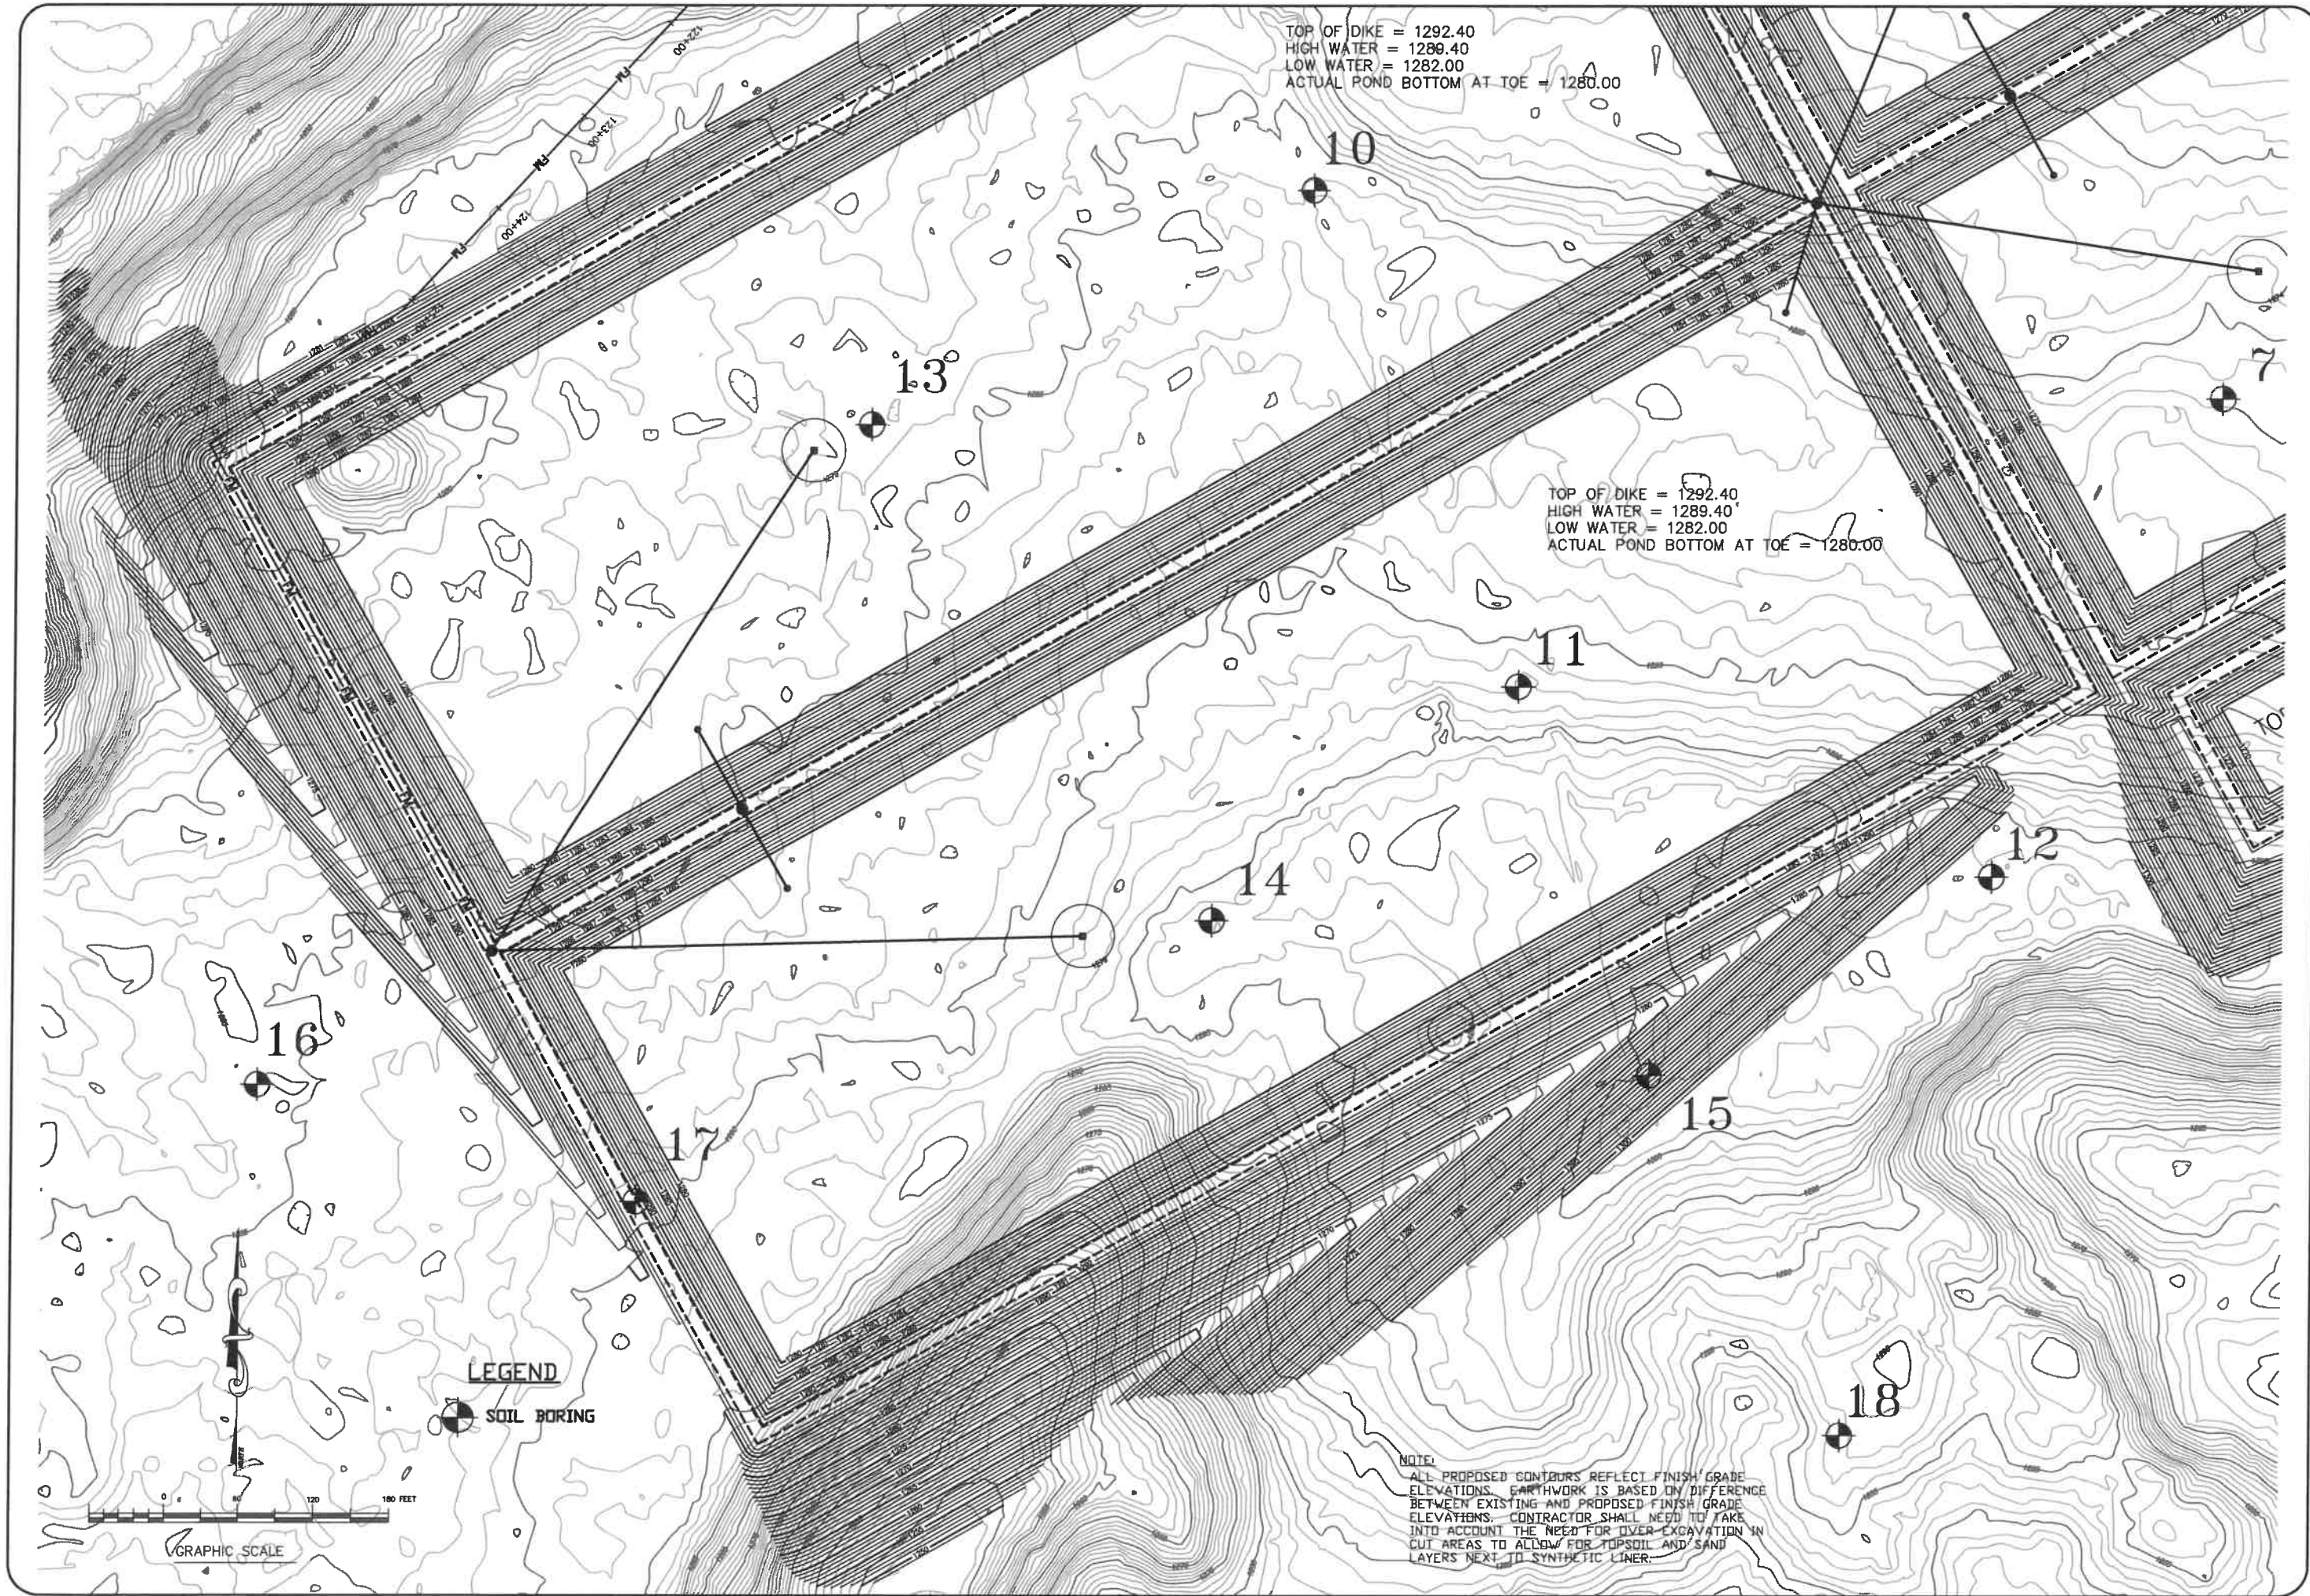

REVISIONS:			
NO.	DATE	DESCRIPTION	BY
AS-BUILT			

I HEREBY CERTIFY THAT THIS PLAN, SPECIFICATION AND CONTRACT DOCUMENTS WERE PREPARED BY ME OR UNDER MY DIRECT SUPERVISION AND THAT I AM A LICENSED PROFESSIONAL REGISTERED ENGINEER UNDER THE LAWS OF THE STATE OF MINNESOTA.

Michael C. McFarlane
MICHAEL C. MCFARLANE
REG. NO. 44108



RED LAKE WASTEWATER FACILITIES


GRADING PLAN 1

RED LAKE RESERVATION, MINNESOTA

JOB NO. 03-42
DATE: 03-29-2011

SHEET NO.
22 OF 27

S:\NED\Projects\03-42 11 waste water (lagoon)\03-42 AS-BUILT\DWG\03-42main.dwg, Sheet 23-Grading 2, 3/29/2011 10:45:00 AM, snopl

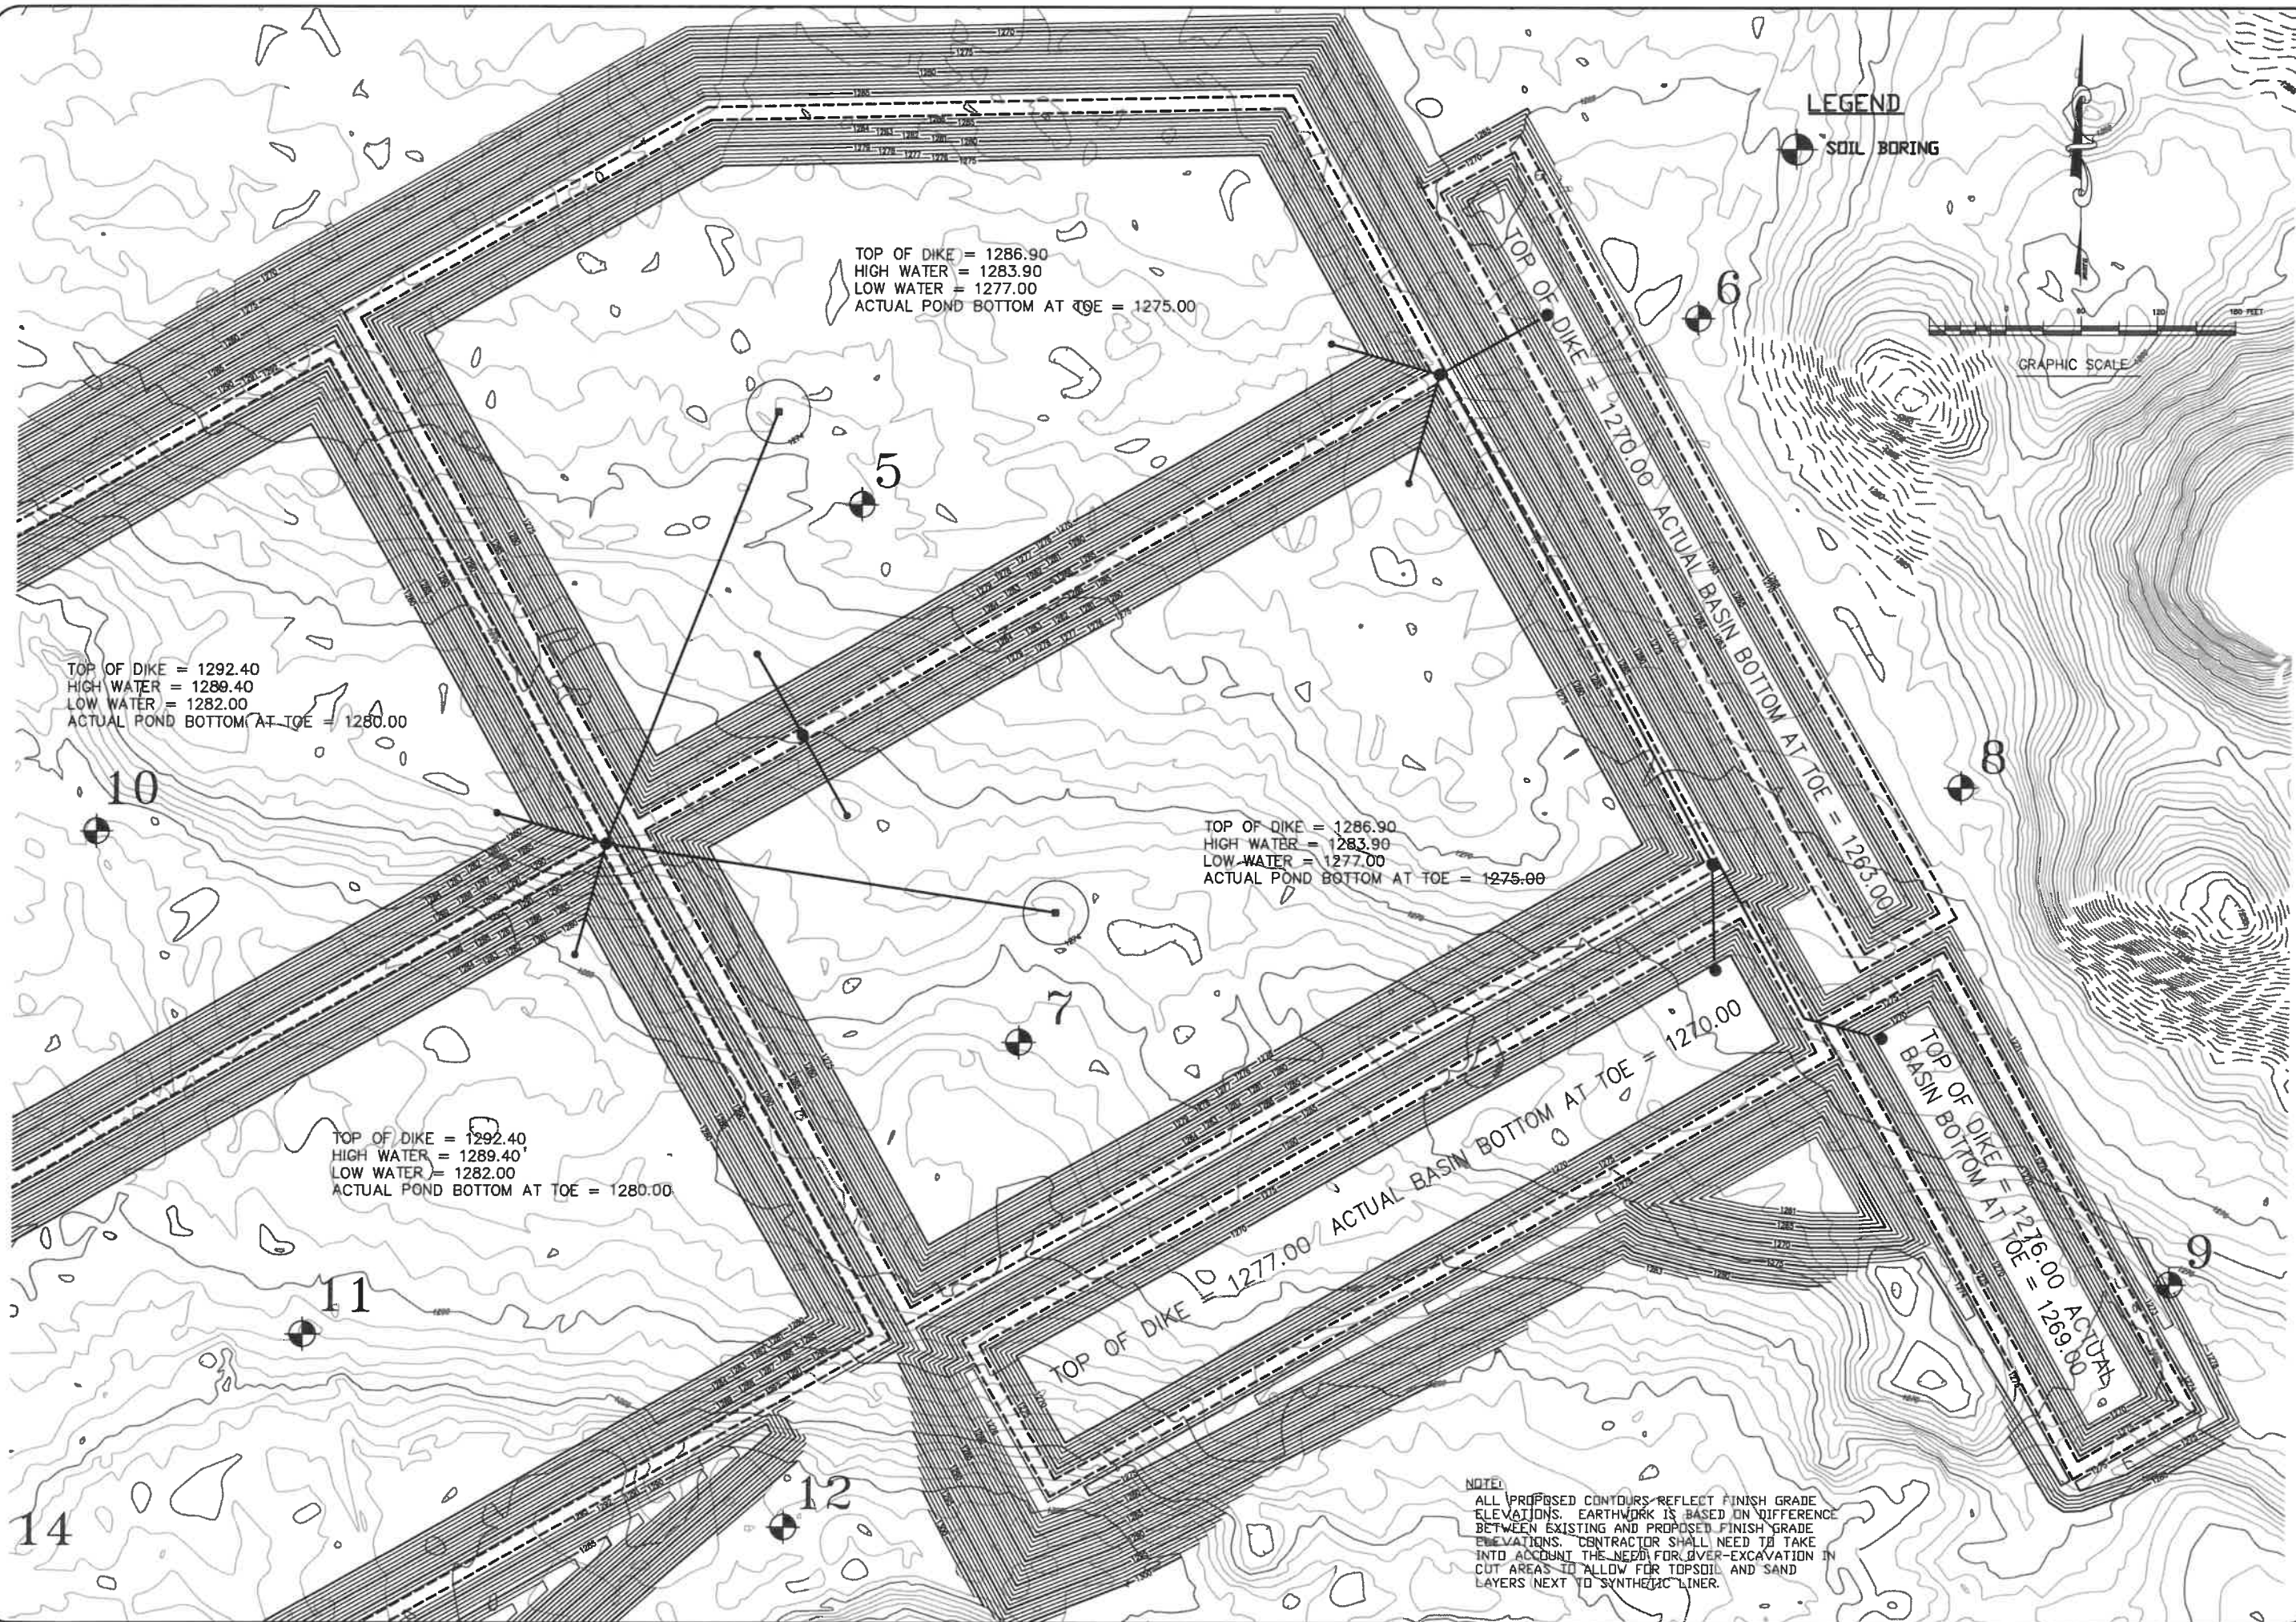

REVISIONS

NO.	DATE	DESCRIPTION
AS-BUILT		

I HEREBY CERTIFY THAT THIS PLAN, SPECIFICATION AND ALL ATTACHED DOCUMENTS WERE PREPARED BY ME OR UNDER MY DIRECT SUPERVISION AND UNDER THE LAWS OF THE STATE OF MINNESOTA.

Michael C. McFarlane
MICHAEL C. MCFARLANE
REG. NO. 44186

NORTHERN ENGINEERING & CONSULTING, INC.
207 4th Street NW, Bemidji, MN 56601
Phone: 218-444-4660, Fax: 218-444-6662
Web: www.necinc.com

RED LAKE WASTEWATER FACILITIES


GRADING PLAN 2

RED LAKE RESERVATION, MINNESOTA

JOB NO. 03-42
DATE: 03-29-2011

SHEET NO.
23 OF 27

S:\NEC\Projects\03-42 r1 waste water (lagoon)\03-42 AS-BUILT\5.dwg (03-42main.dwg, Sheet 25-Finished Surfaces, 3/29/2011, 10:46:56 AM, ssnopl)

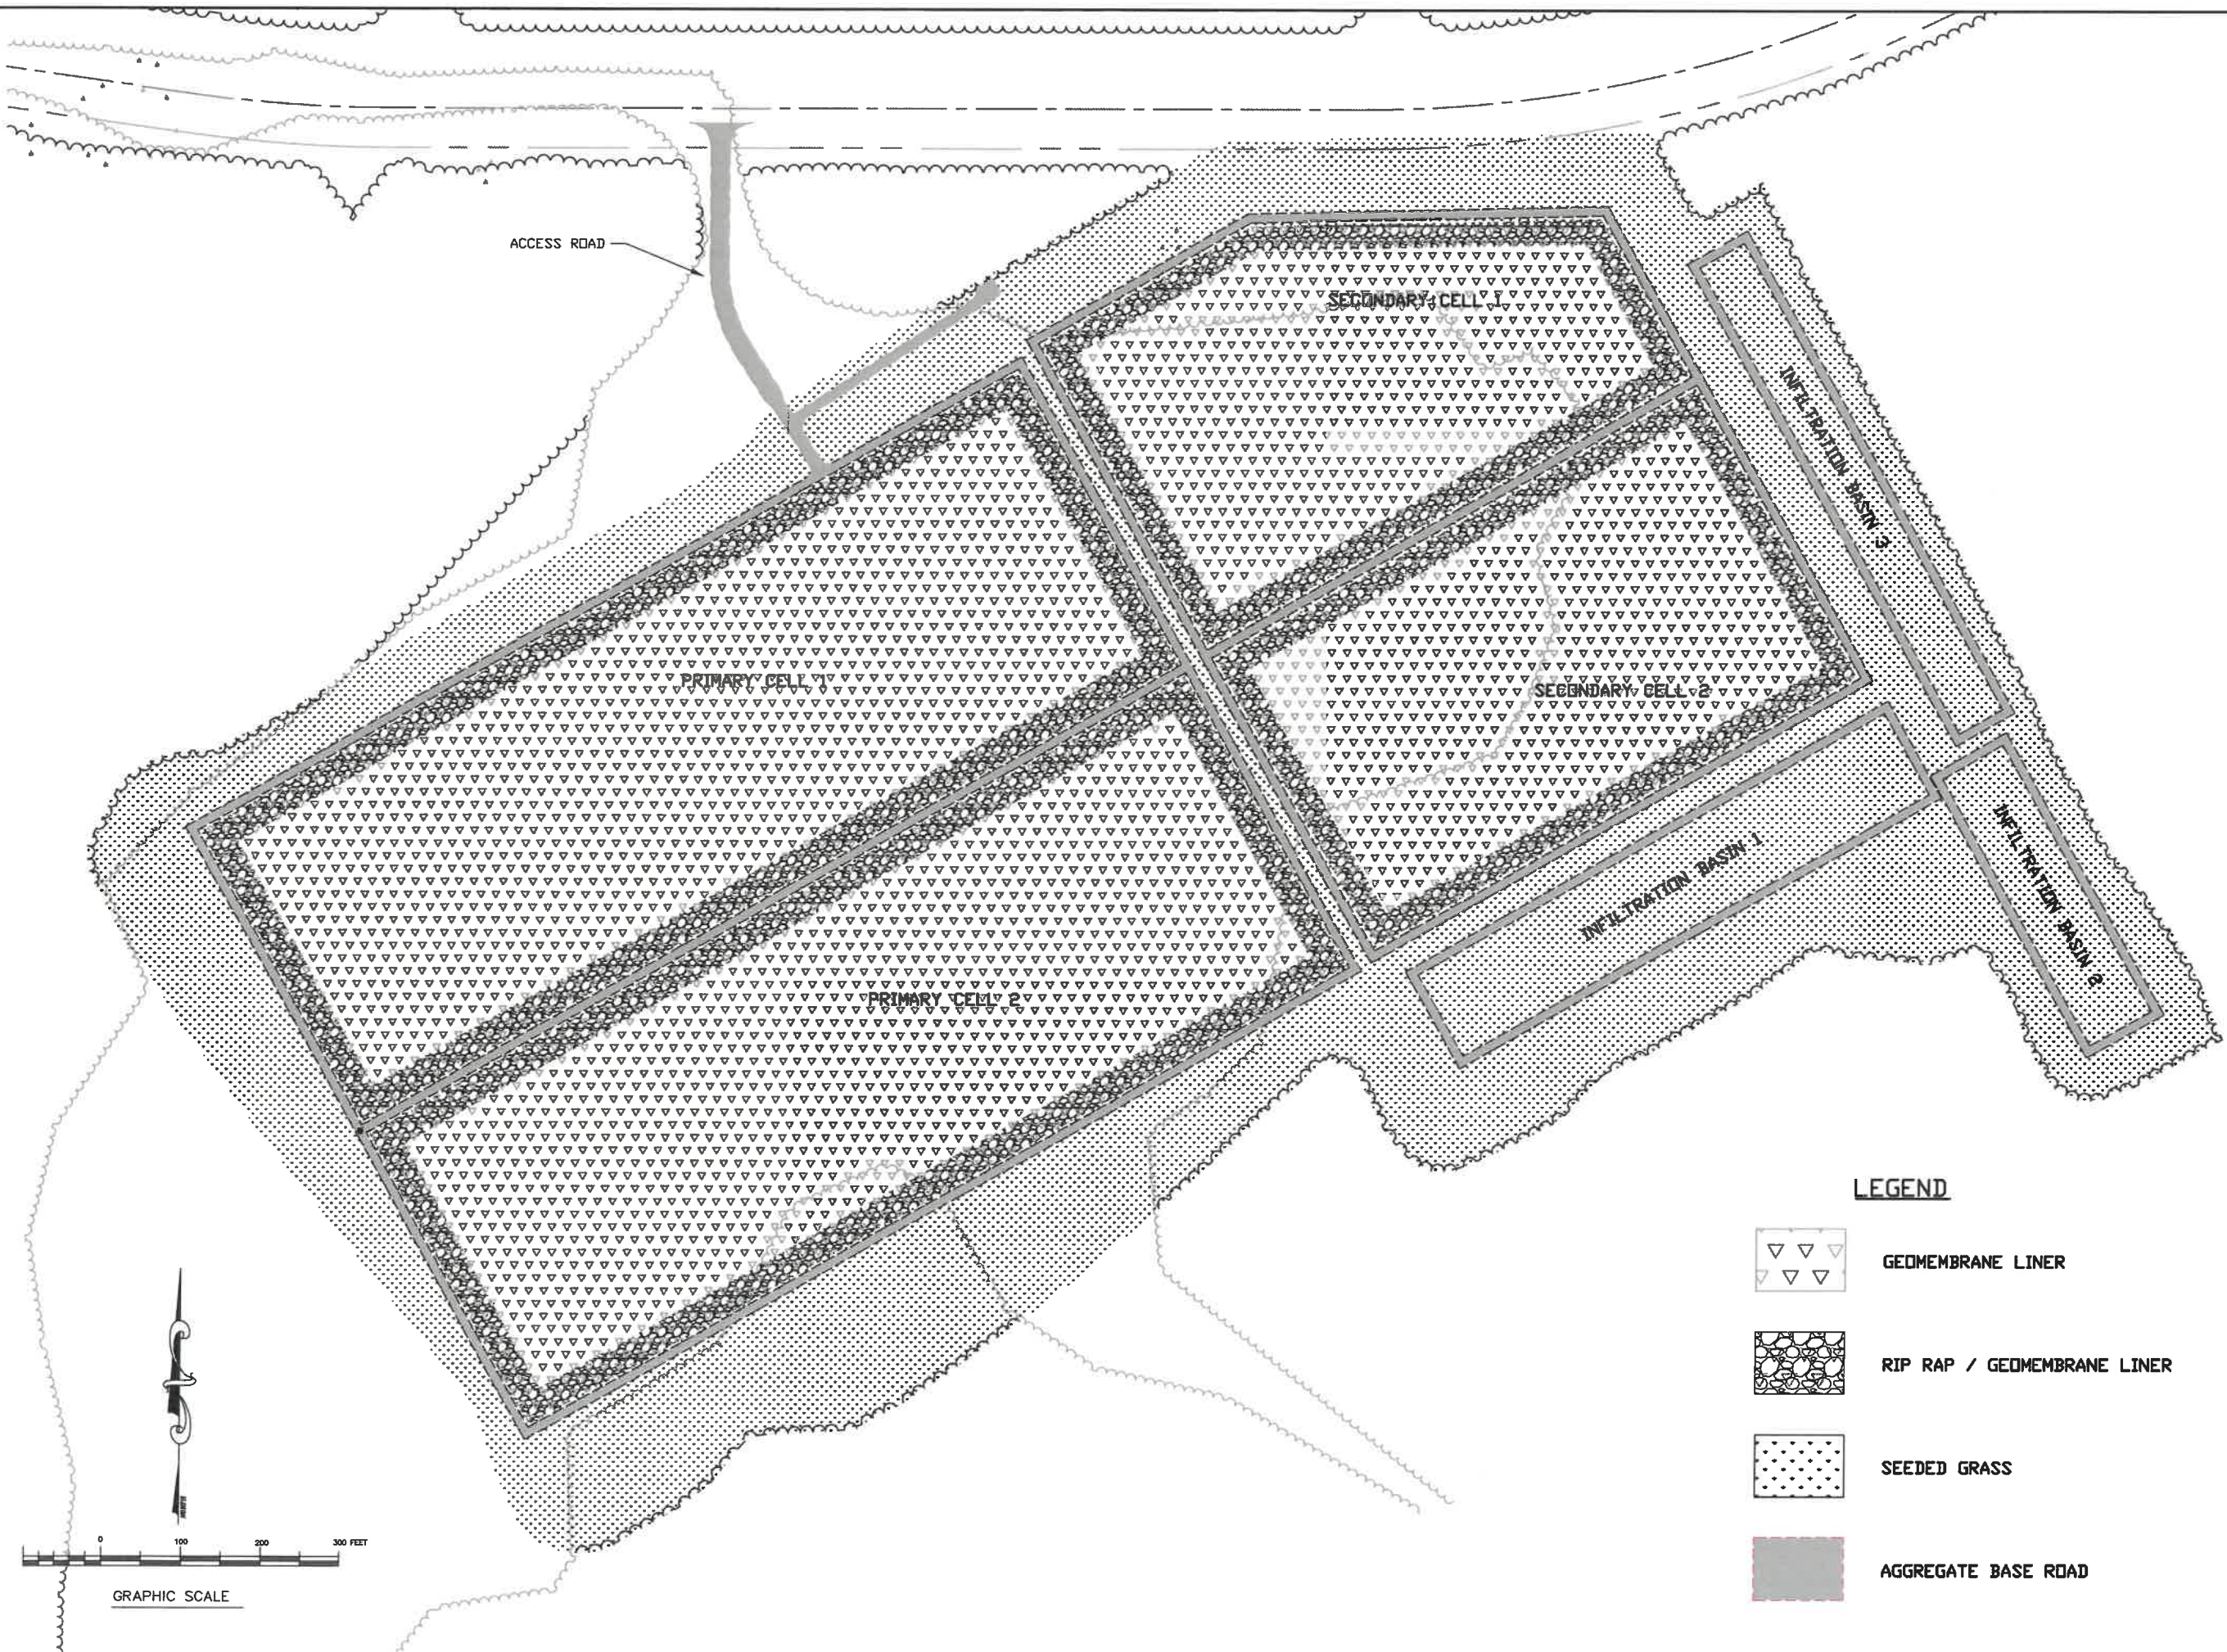

RED LAKE WASTEWATER FACILITIES
SITE SURFACING LAYOUT
RED LAKE RESERVATION, MINNESOTA

JOB NO. 03-42
DATE: 03-29-2011

SHEET NO.
25 OF 27

ARTISTRY ENGINEERING & CONSULTING, INC.
207 4th Street NW, Bemidji, MN 56601
Phone: 218-444-4860, Fax: 218-444-6042
web: www.mnecusa.com


I HEREBY CERTIFY THAT THIS PLAN, SPECIFICATION OR REPORT WAS PREPARED BY ME OR UNDER MY DIRECT SUPERVISION AND THAT I AM A DULY LICENSED PROFESSIONAL ENGINEER UNDER THE LAWS OF THE STATE OF MINNESOTA.

Michael C. McFarlane
MICHAEL C. McFARLANE REG. NO. 44196

REVISIONS:

NO.	DATE	DESCRIPTION	BY
AS-BUILT			

S:\NEC\Projects\03-42 1 waste water (lagoon)\03-42 AS-BUILT5.dwg\03-42main.dwg, Existing Forcemain Connection, 3/29/2011 10:48:28 AM, ssnp1

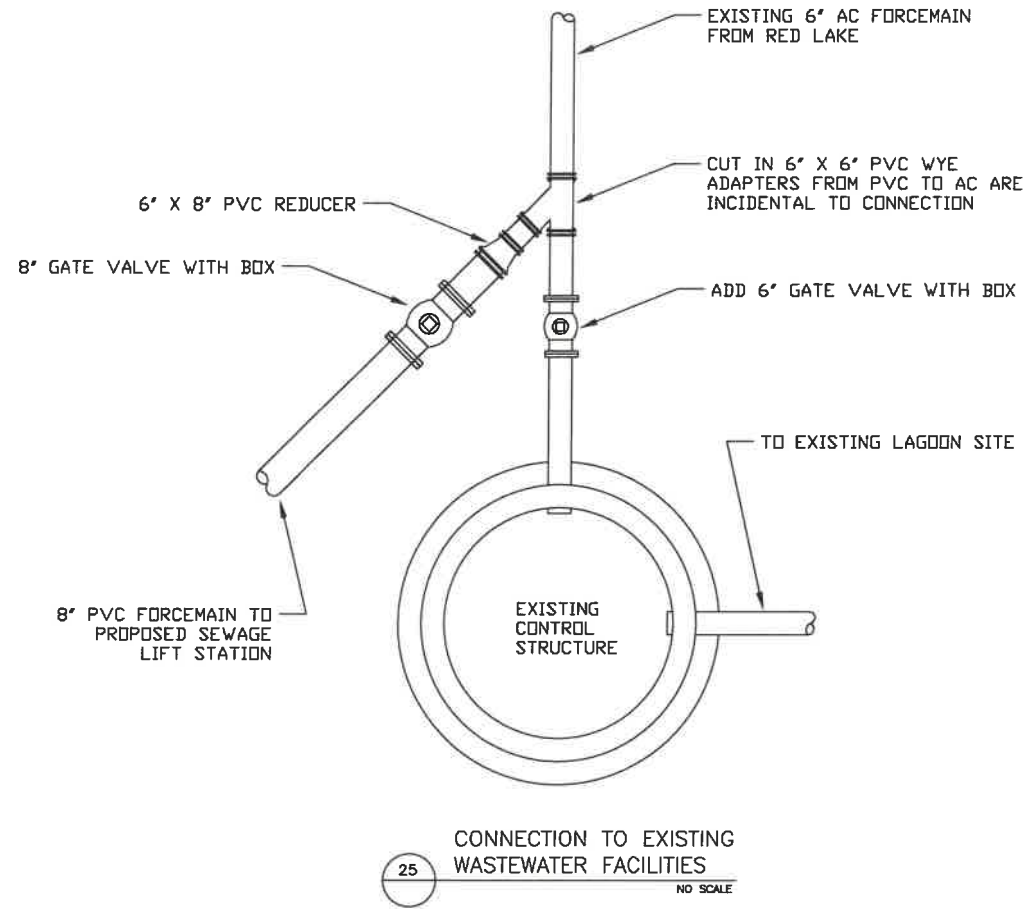

NOTES FOR REHABILITATION OF SECONDARY POND

- ① CONTRACTOR SHALL REMOVE ALL TREES, SHRUBS, BRUSH, AND OTHER VEGETATION OR UNSUITABLE MATERIALS FROM THE EXISTING POND
- ② CONTRACTOR TO SCARIFY AND RECOMPACT ENTIRE POND BOTTOM AND SIDE SLOPES TO AN ELEVATION 6 FEET ABOVE POND BOTTOM. SCARIFICATION SHALL BE TO A DEPTH OF TH INCHES AND RECOMPACTION SHALL BE A MINIMUM OF 95% STANDARD PROCTOR DENSITY.

REVISIONS			
NO.	DATE	DESCRIPTION	BY
AS-BUILT			

I HEREBY CERTIFY THAT THIS PLAN, SPECIFICATION OR REPORT WAS PREPARED BY ME OR UNDER MY CLOSE PERSONAL SUPERVISION AND I AM A LICENSED PROFESSIONAL ENGINEER UNDER THE LAWS OF THE STATE OF MINNESOTA.

Michael C. McFarlane
MICHAEL C. McFARLANE
REG. NO. 44180



RED LAKE WASTEWATER FACILITIES
CONNECTION TO EXISTING FACILITIES
RED LAKE RESERVATION, MINNESOTA

JOB NO. 03-42
DATE: 03-29-2011

SHEET NO.
26 OF 27

S:\INCE\Projects\03-42-rl waste water (Bgoon)\03-42 AS-BUILT.dwg\03-42-EST.dwg, Model: 3/29/2011 2:51:29 PM, srtop1

5.3	GEOMEMBRANE FABRICATION		5.4	Preparation for Seaming		One of the following procedures shall apply whenever a sample fails a destructive test:	C.	Quantity of Specimens	
	Individual colored widths (roll goods) are factory pre-assembled into large panels to minimize field seaming during installation.			A total of ten specimens shall be cut from the sample. Five specimens will be used to perform bonded seam strength testing with the remaining five specimens to be used for peel adhesion testing. Details of the test procedures are outlined in ASTM D751, Modified (Bonded Seam Strength), and ASTM D413, Modified (Peel Adhesion).					
5	Factory seams are produced using chemical, defective or thermal method. Each seaming method is tailored for optimum seam strength.		5.4.1	Seam Preparation		For geomembrane seams that are bonded by the chemical fusion method, the seams must be cured prior to testing. Without the application of heat, the cure times can range from a few hours to a few days. Accelerated curing for on site COC testing requires the use of an oven or other suitable heat source to condition the seam samples from 1 to 16 hours in a temperature range of 122°F to 158°F. Following the accelerated cure period, a post-cure conditioning period of at least 1/2 hour at ambient conditions prior to testing is required.	6.4.6	Acceptance of Destructive Test Results	
	Nominal seam widths, Non-reinforced 1" / Reinforced 1 1/2" seam to seam.			See specifications for minimum specified seam strength values.					
5	Factory pre-assembly production records identify each panel by panel number, size, date of pre-assembly, material lot number and seam station identification. Each panel is prominently marked with the panel number and panel size to coincide with production records.		5.4.2	FIELD SEAMING		Reconstruction of field seams shall be accomplished by removing the suspect seam, repositioning panels and re-seaming, or by installing a cap strip to cover the seam under reconstruction. Cap stripping shall extend a minimum of six inches beyond the reconstructed seam in all directions.	6.4.7	Remedial Action - Destructive Test Failure	
	5.2 IN-FACTORY SEAM TESTING			One of the following procedures shall apply whenever a sample fails a destructive test:					
5	Visual and non-destructive inspection shall be performed on 100% of factory preassembled seams, including ASTM D4545, through a combined use of sections 7.1.1 (CSHA limits) and 7.1.4. Seam type will determine procedure and ratio. All seams are warranted for two (2) years.		5.4.1.1	Repairs		If unbonded areas are located, they can often be repaired by using detail method 5.4 or 5.4.1.1. All patches shall extend a minimum of six inches beyond the area in all directions.	6.4.8	Verification of Repairs	
	In addition, destructive testing on factory fabricated seams in order to verify quality compliance shall be performed.			Any repair requiring a patch or cap strip shall be identified on the as-built drawing. Each repair shall undergo non-destructive testing as described in section 6.3 above. Repairs which pass the NDT shall be taken as an indication of proper repair. Failed NDT's will result in reconstruction and re-testing of the repair area until a passing result is obtained.					
5	Samples of factory seams shall be taken at the beginning and at the end of each production shift. All seams shall be tested for compliance and the results shall be made available to the engineer for materials to be used on the specific job.		5.4.2.1	Cold Weather Thermal Fusion Field Seaming		Generally for cold weather seaming, when the geomembrane surface is below 50°F, the surfaces to be joined must be preheated.	6.4.3	NON-DESTRUCTIVE SEAM TESTING	
	5.3 FACTORY SEAM REQUIREMENTS			6.3.1 Test Methods					
5	All factory seams are tested for Bonded Seam and Peel strength in accordance with Industry (ASTM) standards.		5.4.2.2	Thermal Fusion Field Seaming (Continuous Width)		The two most common seaming methods are Hot Wedge and Hot Air. Either method is capable of producing a quality seam. These units are equipped with speed and temperature controls with digital (LED) readout along with pressure adjustment.	6.4.3.1	NON-DESTRUCTIVE SEAM TESTING	
	5.4 PACKAGING, HANDLING, AND TRANSPORTATION			6.3.1.1 Test Methods					
5	5.4.1 PACKAGING AND HANDLING		5.4.2.3	Pipe Penetrations		Penetrations shall be sealed via the use of factory fabricated pipe seals. Pipe seals are thermally constructed using the same material as the specified geomembrane. For reinforced material, the tube section of the pipe seal shall be constructed using nonreinforced parent material. The method of bonding is as outlined in the field seaming section.	6.4.3.2	NON-DESTRUCTIVE SEAM TESTING	
	After factory pre-assembly, the geomembrane panels are double accordion folded on a pallet or rolled on a cardboard core. Folded panels are shrink wrapped (light reflective) using a wetter and UV resistant polymer sheeting with outer cardboard insert bonded to a heavy duty wooden pallet. Rolled panels are wrapped in a protective layer and shrink wrapped (light reflective). All pallets/rolls are identified by panel size, type, and number. Geomembrane panels delivered to the jobsite are unloaded on level ground, stored in their original, unopened containers in a secure, dry area, and protected from weathering. Whenever possible, a six-inch minimum air space between the pallets should be maintained, especially when the geomembrane panels are to be stored over an extended period of time. Pallets must not be stacked. Bending is not to be removed from the pallet until actual deployment, to insure stability.			The minimum sample geometry shall be as follows:					
5	Material Safety Data Sheets (MSDS) to be provided on all chemicals which include handling and personal protection during usage.		5.4.2.4	LINING SYSTEM ACCEPTANCE		The supplier authorized installer shall retain responsibility for the geomembrane installation until acceptance by the Engineer and/or Owner.	6.4.3.3	NON-DESTRUCTIVE SEAM TESTING	
	5.2 TRANSPORTATION			6.4.3.4					
5	Transportation of the geomembrane will be arranged by supplier, and will be shipped via a closed or flat bed trailer. Adequate tarps (flat bed) are recommended during transport. It is the responsibility of the receiver at the time of delivery to indicate condition of shipment on the Bill of Lading. Any visual damage MUST be noted in WRITING and supplier should be contacted within 24 hours or (extreme conditions) before accepting delivery.		5.4.2.5	FIELD QUALITY ASSURANCE		Field seam quality shall be demonstrated by nondestructive (NDT) and destructive (DT) test methods.	6.4.3.5	NON-DESTRUCTIVE SEAM TESTING	
	5.1 ANCHORAGE SYSTEM			6.4.3.6					
5	Unless otherwise specified, the anchor trench should be excavated by the earthwork contractor or others to the lines and grades shown on the design drawings. Store excavated material away from the area to be lined.		5.4.2.6	OVERVIEW		The primary purpose of the NDT method is to demonstrate continuity along the entire length and to validate 100% of the field seam. NDT methodology is described in section 6.3 below.	6.4.3.7	NON-DESTRUCTIVE SEAM TESTING	
	Complete trenching process prior to geomembrane placement.			The purpose of the DT method is to determine the quality of a given seam by removing a representative seam sample, and testing the given sample for compliance with accepted applicable industry standards. Testing may be conducted either at the job site, or at a remote testing laboratory. DT methodology is discussed in section 6.4 below.					
5	A smooth transition surface from anchor trench to subgrade should be provided.		5.4.2.7	TEST STRIP/TRIAL SEAMS		A general requirement of most CQA Documents is that "test seams" or "test strips" be made on a periodic basis. Test strips generally reflect the quality of field seams but should never be used solely for the final field seam acceptance. Final field seam acceptance requirements should be specified in the contract specification and should include a minimum level of destructive testing of the field seams. Test strips are made to minimize the amount of destructive sampling/testing on the finished panels. Typically these test seams, for each seaming crew, are made once per day, or every time equipment is changed, or if significant changes in site conditions are noted, or as required in the contract specification. The purpose of these tests is to establish that proper seaming materials, temperatures, pressures, rates, and techniques along with the necessary geomembrane pre-seaming preparation are being accomplished. Test strips may be used for CQA/CQC evaluation, and must be of sufficient size in order to conduct required testing.	6.4.3.8	NON-DESTRUCTIVE SEAM TESTING	
	Following the completion of the seaming operation, the anchor trench shall be backfilled and compacted (as soon as possible) by the earthwork contractor to lock in the geomembrane. During ongoing backfilling operations, backfill should be kept a minimum of 10 feet from un-seamed areas.			While cursory test seams are evaluated, the seaming crew may begin and continue to work as long as the field seam being constructed is completely traceable and identifiable. If a test seam fails to meet the field seam design specification, then an additional test seam sample is constructed and re-tested by the same seaming crew, equipment, and materials.					
5	5.2 SUBGRADE		5.4.2.8	OVERVIEW		Field seams will not be accepted unless CQC seam test results coincide as per the design specification are met.	6.4.3.9	NON-DESTRUCTIVE SEAM TESTING	
	5.2.1 Preparation			6.4.3.10					
5	Surfaces to be lined will be free of all rocks, roots, vegetation, sharp objects, or debris of any kind. The surface shall provide a firm, unyielding foundation for the geomembrane with no sharp or abrupt changes in grade.		5.4.2.9	OVERVIEW		The primary purpose of the NDT method is to demonstrate continuity along the entire length and to validate 100% of the field seam. NDT methodology is described in section 6.3 below.	6.4.3.11	NON-DESTRUCTIVE SEAM TESTING	
	If an herbicide is required, it must be suitable for use with geomembranes and shall be applied as per the manufacturer recommendations. Suitability for use with the geomembrane shall be confirmed by the herbicide manufacturer.			6.4.3.12					
5	5.2.2 Repair and Maintenance		5.4.2.10	OVERVIEW		The purpose of the DT method is to determine the quality of a given seam by removing a representative seam sample, and testing the given sample for compliance with accepted applicable industry standards. Testing may be conducted either at the job site, or at a remote testing laboratory. DT methodology is discussed in section 6.4 below.	6.4.3.13	NON-DESTRUCTIVE SEAM TESTING	
	Prior to geomembrane installation, the surfaces to be lined shall be inspected for acceptability by the installers. Any necessary repairs will be made by the owner or earthwork contractor. It is the responsibility of the owner or earthwork contractor to maintain the integrity of the subgrade prior to, and during the geomembrane installation. This includes the control of ground water in the area to be lined.			6.4.3.14					
5	5.3 GEOMEMBRANE PANEL PLACEMENT		5.4.2.11	OVERVIEW		Field seam quality shall be demonstrated by nondestructive (NDT) and destructive (DT) test methods.	6.4.3.15	NON-DESTRUCTIVE SEAM TESTING	
	5.3.1 Panel Location			6.4.3.16					
5	Install the geomembrane as indicated in the approved layout drawing. The installer may modify the proposed layout to best meet the intent of the project specification and/or to accommodate existing site conditions.		5.4.2.12	OVERVIEW		The primary purpose of the NDT method is to demonstrate continuity along the entire length and to validate 100% of the field seam. NDT methodology is described in section 6.3 below.	6.4.3.17	NON-DESTRUCTIVE SEAM TESTING	
	5.3.2 Weather Conditions			6.4.3.18					
5	Consideration must be given to low temperature (<40°F) handling characteristics of the geomembrane before installation. In some cases, before the liner is actually ordered. Please contact supplier if the above condition exists.		5.4.2.13	OVERVIEW		The purpose of the DT method is to determine the quality of a given seam by removing a representative seam sample, and testing the given sample for compliance with accepted applicable industry standards. Testing may be conducted either at the job site, or at a remote testing laboratory. DT methodology is discussed in section 6.4 below.	6.4.3.19	NON-DESTRUCTIVE SEAM TESTING	
	5.3.3 Geomembrane Panel Deployment			6.4.3.20					
5	The number of panels to be deployed in any day shall be limited to the number of panels which can be seamed or secured that day.		5.4.2.14	OVERVIEW		Field seam quality shall be demonstrated by nondestructive (NDT) and destructive (DT) test methods.	6.4.3.21	NON-DESTRUCTIVE SEAM TESTING	
	The geomembrane shall be installed in a relaxed manner and free of tension and stress. In areas where grade transitions occur, "bridging" or "tramping" of the geomembrane shall not be allowed. To accommodate grade transition, adequate slack is necessary. Wrinkling of the geomembrane is acceptable and indicates proper slack consideration.			6.4.3.22					
5	Deploy geomembrane panels to meet a minimum panel overlap of six inches. During cold weather deployment, consideration must be given to reduced packaging geometry (ability to lay flat) as it relates to installation quantity. Single all panels in the down gradient direction whenever possible.		5.4.2.15	OVERVIEW		The primary purpose of the NDT method is to demonstrate continuity along the entire length and to validate 100% of the field seam. NDT methodology is described in section 6.3 below.	6.4.3.23	NON-DESTRUCTIVE SEAM TESTING	
				6.4.3.24					
5			5.4.2.16	OVERVIEW		The purpose of the DT method is to determine the quality of a given seam by removing a representative seam sample, and testing the given sample for compliance with accepted applicable industry standards. Testing may be conducted either at the job site, or at a remote testing laboratory. DT methodology is discussed in section 6.4 below.	6.4.3.25	NON-DESTRUCTIVE SEAM TESTING	
				6.4.3.26					
5			5.4.2.17	OVERVIEW		Field seam quality shall be demonstrated by nondestructive (NDT) and destructive (DT) test methods.	6.4.3.27	NON-DESTRUCTIVE SEAM TESTING	
				6.4.3.28					
5			5.4.2.18	OVERVIEW		The primary purpose of the NDT method is to demonstrate continuity along the entire length and to validate 100% of the field seam. NDT methodology is described in section 6.3 below.	6.4.3.29	NON-DESTRUCTIVE SEAM TESTING	
				6.4.3.30					
5			5.4.2.19	OVERVIEW		The purpose of the DT method is to determine the quality of a given seam by removing a representative seam sample, and testing the given sample for compliance with accepted applicable industry standards. Testing may be conducted either at the job site, or at a remote testing laboratory. DT methodology is discussed in section 6.4 below.	6.4.3.31	NON-DESTRUCTIVE SEAM TESTING	
				6.4.3.32					
5			5.4.2.20	OVERVIEW		Field seam quality shall be demonstrated by nondestructive (NDT) and destructive (DT) test methods.	6.4.3.33	NON-DESTRUCTIVE SEAM TESTING	
				6.4.3.34					
5			5.4.2.21	OVERVIEW		The primary purpose of the NDT method is to demonstrate continuity along the entire length and to validate 100% of the field seam. NDT methodology is described in section 6.3 below.	6.4.3.35	NON-DESTRUCTIVE SEAM TESTING	
				6.4.3.36					
5			5.4.2.22	OVERVIEW		The purpose of the DT method is to determine the quality of a given seam by removing a representative seam sample, and testing the given sample for compliance with accepted applicable industry standards. Testing may be conducted either at the job site, or at a remote testing laboratory. DT methodology is discussed in section 6.4 below.	6.4.3.37	NON-DESTRUCTIVE SEAM TESTING	
				6.4.3.38					
5			5.4.2.23	OVERVIEW		Field seam quality shall be demonstrated by nondestructive (NDT) and destructive (DT) test methods.	6.4.3.39	NON-DESTRUCTIVE SEAM TESTING	
				6.4.3.40					
5			5.4.2.24	OVERVIEW		The primary purpose of the NDT method is to demonstrate continuity along the entire length and to validate 100% of the field seam. NDT methodology is described in section 6.3 below.	6.4.3.41	NON-DESTRUCTIVE SEAM TESTING	
				6.4.3.42					
5			5.4.2.25	OVERVIEW		The purpose of the DT method is to determine the quality of a given seam by removing a representative seam sample, and testing the given sample for compliance with accepted applicable industry standards. Testing may be conducted either at the job site, or at a remote testing laboratory. DT methodology is discussed in section 6.4 below.	6.4.3.43	NON-DESTRUCTIVE SEAM TESTING	
				6.4.3.44					
5			5.4.2.26	OVERVIEW		Field seam quality shall be demonstrated by nondestructive (NDT) and destructive (DT) test methods.	6.4.3.45	NON-DESTRUCTIVE SEAM TESTING	
				6.4.3.46					
5			5.4.2.27	OVERVIEW		The primary purpose of the NDT method is to demonstrate continuity along the entire length and to validate 100% of the field seam. NDT methodology is described in section 6.3 below.	6.4.3.47	NON-DESTRUCTIVE SEAM TESTING	
				6.4.3.48					
5			5.4.2.28	OVERVIEW		The purpose of the DT method is to determine the quality of a given seam by removing a representative seam sample, and testing the given sample for compliance with accepted applicable industry standards. Testing may be conducted either at the job site, or at a remote testing laboratory. DT methodology is discussed in section 6.4 below.	6.4.3.49	NON-DESTRUCTIVE SEAM TESTING	
				6.4.3.50					
5			5.4.2.29	OVERVIEW		Field seam quality shall be demonstrated by nondestructive (NDT) and destructive (DT) test methods.	6.4.3.51	NON-DESTRUCTIVE SEAM TESTING	
				6.4.3.52					
5			5.4.2.30	OVERVIEW		The primary purpose of the NDT method is to demonstrate continuity along the entire length and to validate 100% of the field seam. NDT methodology is described in section 6.3 below.	6.4.3.53	NON-DESTRUCTIVE SEAM TESTING	
				6.4.3.54					
5			5.4.2.31	OVERVIEW		The purpose of the DT method is to determine the quality of a given seam by removing a representative seam sample, and testing the given sample for compliance with accepted applicable industry standards. Testing may be conducted either at the job site, or at a remote testing laboratory. DT methodology is discussed in section 6.4 below.	6.4.3.55	NON-DESTRUCTIVE SEAM TESTING	
				6.4.3.56					
5			5.4.2.32	OVERVIEW		Field seam quality shall be demonstrated by nondestructive (NDT) and destructive (DT) test methods.	6.4.3.57	NON-DESTRUCTIVE SEAM TESTING	
				6.4.3.58					
5			5.4.2.33	OVERVIEW		The primary purpose of the NDT method is to demonstrate continuity along the entire length and to validate 100% of the field seam. NDT methodology is described in section 6.3 below.	6.4.3.59	NON-DESTRUCTIVE SEAM TESTING	
				6.4.3.60					
5			5.4.2.34	OVERVIEW		The purpose of the DT method is to determine the quality of a given seam by removing a representative seam sample, and testing the given sample for compliance with accepted applicable industry standards. Testing may be conducted either at the job site, or at a remote testing laboratory. DT methodology is discussed in section 6.4 below.	6.4.3.61	NON-DESTRUCTIVE SEAM TESTING	
				6.4.3.62					
5			5.4.2.35	OVERVIEW		Field seam quality shall be demonstrated by nondestructive (NDT) and destructive (DT) test methods.	6.4.3.63	NON-DESTRUCTIVE SEAM TESTING	
				6.4.3.64					
5			5.4.2.36	OVERVIEW		The primary purpose of the NDT method is to demonstrate continuity along the entire length and to validate 100% of the field seam. NDT methodology is described in section 6.3 below.	6.4.3.65	NON-DESTRUCTIVE SEAM TESTING	
				6.4.3.66					
5			5.4.2.37	OVERVIEW		The purpose of the DT method is to determine the quality of a given seam by removing a representative seam sample, and testing the given sample for compliance with accepted applicable industry standards. Testing may be conducted either at the job site, or at a remote testing laboratory. DT methodology is discussed in section 6.4 below.	6.4.3.67	NON-DESTRUCTIVE SEAM TESTING	
				6.4.3.68					
5			5.4.2.38	OVERVIEW		Field seam quality shall be demonstrated by nondestructive (NDT) and destructive (DT) test methods.	6.4.3.69	NON-DESTRUCTIVE SEAM TESTING	
				6.4.3.70					
5			5.4.2.39	OVERVIEW		The primary purpose of the NDT method is to demonstrate continuity along the entire length and to validate 100% of the field seam. NDT methodology is described in section 6.3 below.	6.4.3.71	NON-DESTRUCTIVE SEAM TESTING	
				6.4.3.72					
5			5.4.2.40	OVERVIEW		The purpose of the DT method is to determine the quality of a given seam by removing a representative seam sample, and testing the given sample for compliance with accepted applicable industry standards. Testing may be conducted either at the job site, or at a remote testing laboratory. DT methodology is discussed in section 6.4 below.	6.4.3.73	NON-DESTRUCTIVE SEAM TESTING	
				6.4.3.74					
5			5.4.2.41	OVERVIEW		Field seam quality shall be demonstrated by nondestructive (NDT) and destructive (DT) test methods.	6.4.3.75	NON-DESTRUCTIVE SEAM TESTING	
				6.4.3.76					
5			5.4.2.42	OVERVIEW		The primary purpose of the NDT method is to demonstrate continuity along the entire length and to validate 100% of the field seam. NDT methodology is described in section 6.3 below.	6.4.3.77	NON-DESTRUCTIVE SEAM TESTING	
				6.4.3.78					
5			5.4.2.43	OVERVIEW		The purpose of the DT method is to determine the quality of a given seam by removing a representative seam sample, and testing the given sample for compliance with accepted applicable industry standards. Testing may be conducted either at the job site, or at a remote testing laboratory. DT methodology is discussed in section 6.4 below.	6.4.3.79	NON-DESTRUCTIVE SEAM TESTING	
				6.4.3.80					
5			5.4.2.44	OVERVIEW		Field seam quality shall be demonstrated by nondestructive (NDT) and destructive (DT) test methods.	6.4.3.81	NON-DESTRUCTIVE SEAM TESTING	
				6.4.3.82					
5			5.4.2.45	OVERVIEW		The primary purpose of the NDT method is to demonstrate continuity along the entire length and to validate 100% of the field seam. NDT methodology is described in section 6.3 below.	6.4.3.83	NON-DESTRUCTIVE SEAM TESTING	
				6.4.3.84					
5			5.4.2.46	OVERVIEW		The purpose of the DT method is to determine the quality of a given seam by removing a representative seam sample, and testing the given sample for compliance with accepted applicable industry standards. Testing may be conducted either at the job site, or at a remote testing laboratory. DT methodology is discussed in section 6.4 below.	6.4.3.85	NON-DESTRUCTIVE SEAM TESTING	
				6.4.3.86					
5			5.4.2.47	OVERVIEW		Field seam quality shall be demonstrated by nondestructive (NDT) and destructive (DT) test methods.	6.4.3.87	NON-DESTRUCTIVE SEAM TESTING	
				6.4.3.88					
5			5.4.2.48	OVERVIEW		The primary purpose of the NDT method is to demonstrate continuity along the entire length and to validate 100% of the field seam. NDT methodology is described in section 6.3 below.	6.4.3.89	NON-DESTRUCTIVE SEAM TESTING	
				6.4.3.90					
5			5.4.2.49	OVERVIEW		The purpose of the DT method is to determine the quality of a given seam by removing a representative seam sample, and testing the given sample for compliance with accepted applicable industry standards. Testing may be conducted either at the job site, or at a remote testing laboratory. DT methodology is discussed in section 6.4 below.	6.4.3.91	NON-DESTRUCTIVE SEAM TESTING	
				6.4.3.92					
5			5.4.2.50	OVERVIEW		Field seam quality shall be demonstrated by nondestructive (NDT) and destructive (DT) test methods.	6.4.3.93	NON-DESTRUCTIVE SEAM TESTING	
				6.4.3.94					
5			5.4.2.51	OVERVIEW		The primary purpose of the NDT method is to demonstrate continuity along the entire length and to validate 100% of the field seam. NDT methodology is described in section 6.3 below.	6.4.3.95	NON-DESTRUCTIVE SEAM TESTING	
				6.4.3.96					
5			5.4.2.52	OVERVIEW		The purpose of the DT method is to determine the quality of a given seam by removing a representative seam sample, and testing the given sample for compliance with accepted applicable industry standards. Testing may be conducted either at the job site, or at a remote testing laboratory. DT methodology is discussed in section 6.4 below.	6.4.3.97	NON-DESTRUCTIVE SEAM TESTING	
				6.4.3.98					
5			5.4.2.53	OVERVIEW		Field seam quality shall be demonstrated by nondestructive (NDT) and destructive (DT) test methods.	6.4.3.99	NON-DESTRUCTIVE SEAM TESTING	
				6.4.3.100					
5			5.4.2.54	OVERVIEW		The primary purpose of the NDT method is to demonstrate continuity along the entire length and to validate 100% of the field seam. NDT methodology is described in section 6.3 below.	6.4.3.101	NON-DESTRUCTIVE SEAM TESTING	
				6.4.3.102					
5			5.4.2.55	OVERVIEW		The purpose of the DT method is to determine the quality of a given seam by removing a representative seam sample, and testing the given sample for compliance with accepted applicable industry standards. Testing may be conducted either at the job site, or at a remote testing laboratory. DT methodology is discussed in section 6.4 below.	6.4.3.103	NON-DESTRUCTIVE SEAM TESTING	
				6.4.3.104					
5			5.4.2.56	OVERVIEW		Field seam quality shall be demonstrated by nondestructive (NDT) and destructive (DT) test methods.	6.4.3.105	NON-DESTRUCTIVE SEAM TESTING	
				6.4.3.106					
5			5.4.2.57	OVERVIEW		The primary purpose of the NDT method is to demonstrate continuity along the entire length and to validate 100% of the field seam. NDT methodology is described in section 6.3 below.	6.4.3.107	NON-DESTRUCTIVE SEAM TESTING	
				6.4.3.108					
5			5.4.2.58	OVERVIEW		The purpose of the DT method is to determine the quality of a given seam by removing a representative seam sample, and testing the given sample for compliance with accepted applicable industry standards. Testing may be conducted either at the job site, or at a remote testing laboratory. DT methodology is discussed in section 6.4 below.	6.4.3.109	NON-DESTRUCTIVE SEAM TESTING	
				6.4.3.110					
5			5.4.2.59	OVERVIEW		Field seam quality shall be demonstrated by nondestructive (NDT) and destructive (DT) test methods.	6.4.3.111	NON-DESTRUCTIVE SEAM TESTING	
				6.4.3.112					
5			5.4.2.60	OVERVIEW		The primary purpose of the NDT method is to demonstrate continuity along the entire length and to validate 100% of the field seam. NDT methodology is described in section 6.3 below.	6.4.3.113	NON-DESTRUCTIVE SEAM TESTING	
				6.4.3.114					
5			5.4.2.61	OVERVIEW		The purpose of the DT method is to determine the quality of a given seam by removing a representative seam sample, and testing the given sample for compliance with accepted applicable industry standards. Testing may be conducted either at the job site, or at a remote testing laboratory. DT methodology is discussed in section 6.4 below.	6.4.3.115	NON-DESTRUCTIVE SEAM TESTING	
				6.4.3.116					
5			5.4.2.62	OVERVIEW		Field seam quality shall be demonstrated by nondestructive (NDT) and destructive (DT) test methods.	6.4.3.117	NON-DESTRUCTIVE SEAM TESTING	
				6.4.3.118					
5			5.4.2.63	OVERVIEW		The primary purpose of the NDT method is to demonstrate continuity along			